



OFFICE OF THE
DOUGLAS COUNTY SURVEYOR

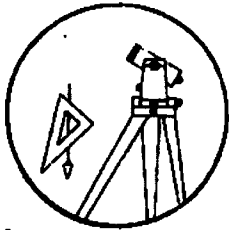

B-112

Station: BEN 24 T 28 S, R 2 E, Sec 6
 Set By (Agency): U.S.G.S.
 Date Set: 1954
 Recovered By SJF, RWS
 Date Recovered Aug. 31, 1987
 Recovered By _____
 Date Recovered _____
 Recovered By _____
 Date Recovered _____

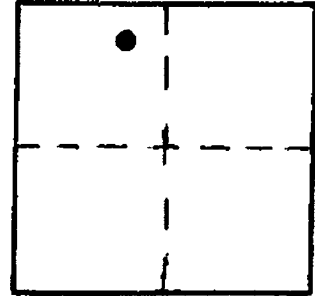

VERTICAL CONTROL NGVD 29 CORPCON 6 NAVD88 4688.86 FT
 Elevation: 4685.01 ft. NGS Line # _____ USGS Line # 143 OSHD Line # _____
 Precision: 3rd order Agency: USGS Proj. # _____ Date: 1965


HORIZONTAL CONTROL
 South Zone State Plane Coordinates: Y(Northing) _____ X(Easting) _____
 Precision: _____ Agency: _____ Proj. # _____ Date: _____
 Approximate Geographic Position: Latitude _____ Longitude _____

DESCRIPTION and TO REACH

A 3 1/2 inch diameter U.S.G.S. aluminum disk stamped "BEN 24 1954" set in an approximately 400x600 foot lava rock outcrop.

TO REACH:

At the intersection of U.S.F.S. road 2814 and spur road 800 in T28S, R2E, Section 6. The monument lies approximately 500 feet N79°W from the intersection.

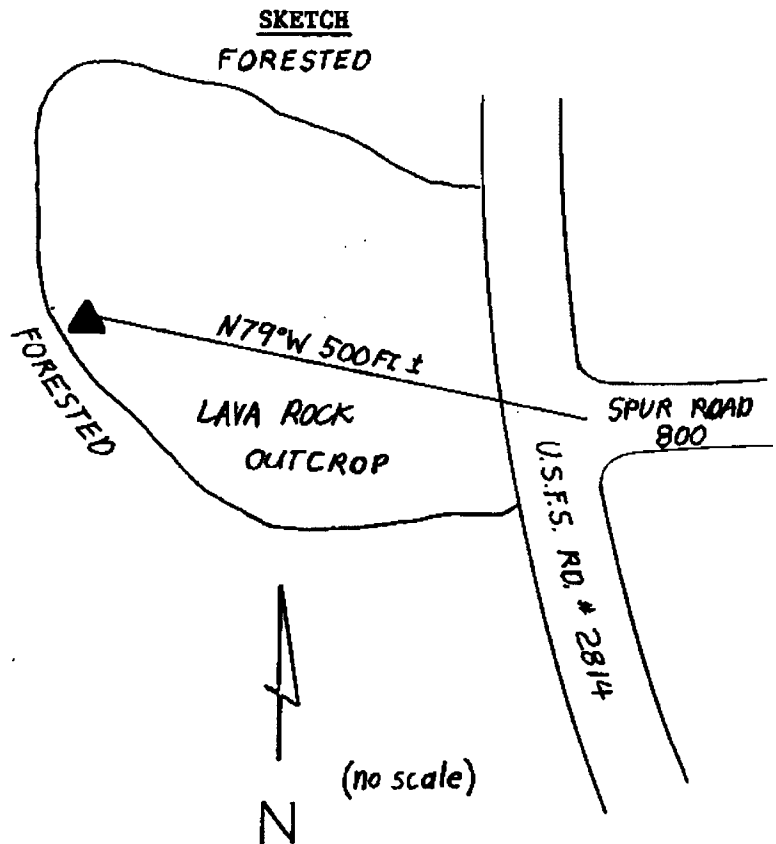

Reference Marks:

Note: For further information, contact the Douglas County Surveyor's Office, Room 205 Douglas County Justice Building, Roseburg, OR 97470. Phone 440-4278. Douglas County residents outside the Roseburg calling area, dial toll free 1-800-452-0991.