

OFFICE OF THE  
DOUGLAS COUNTY SURVEYOR

Station: B 739

T21W R4W Sec. 30

Date Set: 1987

Set By (Agency): NGS

DCSO Designation: B-129

Date Recovered: 7-93



Recovered By: SJF

Date Recovered: \_\_\_\_\_

Recovered By: \_\_\_\_\_

Date Recovered: \_\_\_\_\_

Recovered By: \_\_\_\_\_

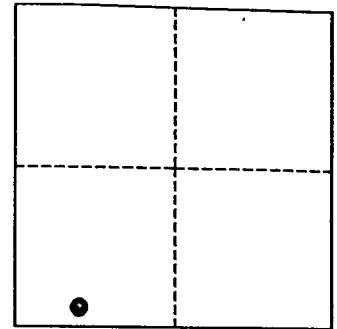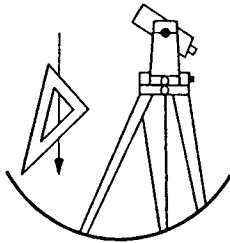

VERTICAL CONTROL

~~NAVD 88~~  
NAVD 29 Elevation: 403.799 FEET      NAVD 88 Elevation: 123.078 METERS

NGS Line # L25035    USGS LINE # \_\_\_\_\_    OSHD Line # \_\_\_\_\_    FILE # \_\_\_\_\_

Precision: 1ST ORDER    Agency: NGS    Proj: \_\_\_\_\_    Date: 1988

HORIZONTAL CONTROL

O.C.S. 27    Y(Northing): \_\_\_\_\_    O.C.S. 83    Y(Northing): 755505

(South Zone)    X(Easting): \_\_\_\_\_    (South Zone)    X(Easting): 4201049

Precision: GIS SCALED    Agency: DCSO    Proj: \_\_\_\_\_    Date: 2014

Approx. O.C.S. 27 Geographic Position:    Latitude: 43°42'42"    Longitude: 123°13'02"

Approx. O.C.S. 83 Geographic Position:    Latitude: \_\_\_\_\_    Longitude: \_\_\_\_\_

Found: A 3 - 5/8 inch diameter NGS disk stamped "B 739 1987" set flush and vertically in the West face of the North end of East concrete abutment of State Hwy. 38 overpass of SPRR.

To reach: From the intersection of I-5 and State Hwy. 38 in T21S R4W Sec30, proceed Westerly along State Hwy. 38, 0.35 miles to State Hwy. 38 overpass of SPRR, monument is at the Northeast corner of overpass.

