

Station: BUSTER

T 22 S, R 9, Sec 14



Date Set: 7/9/96

Set By (Agency): DCSO

Date Recovered: 7/9/96

Recovered By: TF, LEM

- Found
- New
- Reset
- Not Found
- Referenced
- Destroyed

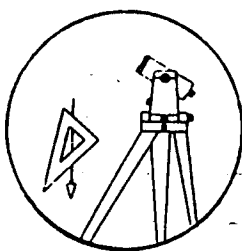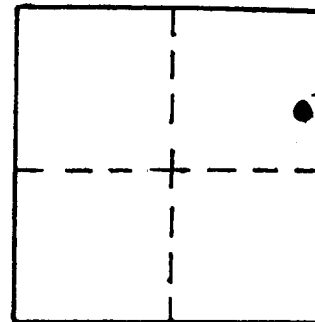

B-140

*PID#
AI 1985*

VERTICAL CONTROL

NAVD 88

Elevation: 73 NGS Line # _____ USGS Line # _____ OSHD Line # _____

Precision: GPS Agency: NGS Proj. # _____ Date: 2012

HORIZONTAL CONTROL

South Zone O.C.S. 27: Y(Northing) _____ X(Easting) _____

South Zone O.C.S. 83: Y(Northing) 743056.562 X(Easting) 4067922.194

Precision: CBN Agency: NGS Proj. # _____ Date: 2011

Approx. NAD ~~83~~ ₂₇ Geographic Position: Latitude 43° 39' 38.1" Longitude 123° 43' 27.6"

DESCRIPTION and TO REACH

SET: A 8" x 42" CONCRETE FILLED BELLTILE BURIED FLUSH WITH GROUND

1 FT NORTH OF DCSO SURVEY MARKER SIGN 2 FT HIGHER THAN PAVED HWY

FROM INTERSECTION OF WEATHERLY CREEK RD, AND ST. HWY 38 PROCEED
EASTERLY ALONG ST. HWY 38, 0.6 MI. TO MONUMENT ON SOUTHERLY
SIDE OF ROAD. MONUMENT IS 0.35 MI. EAST OF M.P. 23.

Reference Marks:

