


OFFICE OF THE
DOUGLAS COUNTY SURVEYOR


B-142

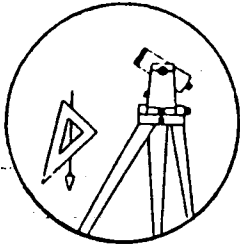

Station: BM 107
Date Set: 13
Set By (Agency): ?
Date Recovered: 8-18-94
Recovered By: RUS SJF

T 23 S, R 5, Sec 3

- Found
- Reset
- Referenced
- New
- Not Found
- Destroyed

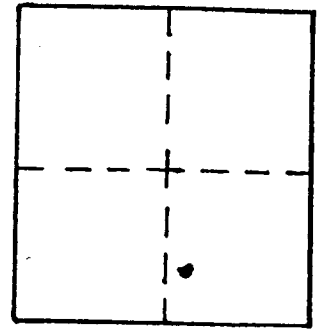

VERTICAL CONTROL

Elevation: 354.67 NGS Line # _____ USGS Line # _____ OSHD Line # _____
Precision: 3rd Agency: DCSO Proj. # 2007 Date: 1994

HORIZONTAL CONTROL CORPSCON6 NAVD80 358.26 FT. CS66/5A

South Zone O.C.S. 27: Y(Northing) _____ X(Easting) _____

South Zone O.C.S. 83: Y(Northing) 714598 X(Easting) 4185984

Precision: GIS SCALED Agency: DCSO Proj. # _____ Date: 2014

Approx. Geographic Position: Latitude 43° 35' 38" Longitude 123° 16' 29"

DESCRIPTION and TO REACH

BOAT SPIKE WITH WASHER IN SOUTH EAST CORNER
OF CONCRETE ABUTMENT WING WALL, STAMPED
"107"

FROM THE INTERSECTION OF EAGLE VALLEY RD
(CO. RD #389 FORMERLY STATE HWY 98) AND ELKHEAD RD
(CO. RD #7) IN T23S R5W SEC 3, PROCEED EASTERLY
ALONG ELKHEAD RD APPROX. 0.3 MILE TO
BRIDGE OVER SMALL CREEK AND BOAT SPIKE
IN SOUTH EAST CORNER

Reference Marks:

