

OFFICE OF THE DOUGLAS COUNTY SURVEYOR



Station: BM 7/4.1 T 23 S, R 4W, Sec 6

Date Set: 1988

Set By (Agency): RLS 2268 ARTMAN

Date Recovered: 2-11-97

Recovered By: RWS SJF

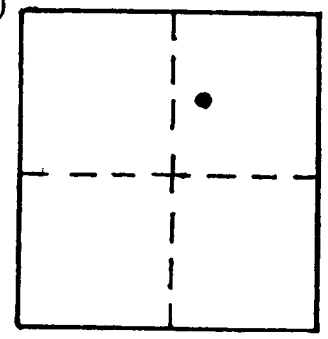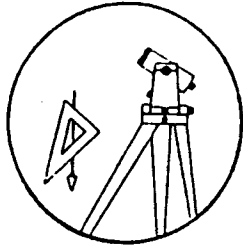

- Found
- New
- Reset
- Not Found
- Referenced
- Destroyed

VERTICAL CONTROL

Elevation: 457.84 NGS Line # _____ USGS Line # _____ OSHD Line # _____
 Precision: 3rd Agency: DCSO Proj. # 2007 Date: 1997

HORIZONTAL CONTROL CORPSCON6 NAVDBB 461.47 FT. CS 66154

South Zone O.C.S. 27: Y(Northing) _____ X(Easting) _____
 South Zone O.C.S. 83: Y(Northing) 716829 X(Easting) 4202511
 Precision: GIS SCALED Agency: DCSO Proj. # _____ Date: 2014
 Approx. 1923 Geographic Position: Latitude 43°36'06" Longitude 123°12'46"

DESCRIPTION and TO REACH

3/4" BOLT THROUGH A 1 3/4" METAL WASHER
WITH STAMP MARK "92" W/STAMP "7/4.1"
SET IN SW CORNER OF CONC BRIDGE CURB,
FROM THE INTERSECTION OF CO. RD # 8
(SCOTTS VALLEY RD) AND CO. RD # 7 (ELK HEAD ROAD)
IN T 23 R 4W SEC 31 PROCEED SOUTHERLY
ALONG CO. RD # 7 0.6 MILE TO MONUMENT
ON RIGHT IN SW CORNER OF CONCRETE BRIDGE,

Reference Marks:

