

Douglas County Geodetic Data Sheet


Station: BRUM

Designation: B-148

T 26 R 06 W S 23

Date Set: 1998 Set By (Agency): DCSO

Last Date Recovered: 08/31/1998

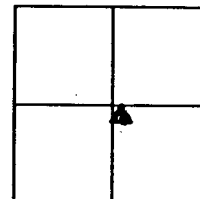

VERTICAL CONTROL

NGVD 29 Elevation: 439.68 Feet

Precision: 3RD ORDER Agency: DCSO

CS File: 66027

Date: 1998

NAVD 88 Elevation: 443.16 FT

Precision: CORPSCON6
NAVD88 Agency:

CS File:

Date:

HORIZONTAL CONTROL

OCS 27 Y(Northing): X(Easting):

Lat

Long:

Precision: Agency:

CS File:

Date:

OCS 83 Y(Northing): 606377 X(Easting): 4156125 Lat

Long:

Precision: 6B SCALED Agency: DCSO

CS File:

Date: 2014

OCS 83/91 Y(Northing): X(Easting):

Lat

Long:

Precision: Agency:

CS File:

Date:

OCS 83/98 Y(Northing): X(Easting):

Lat

Long:

Precision: Agency:

CS File:

Date:

Description:

Scaled Lat 43° 17' 41"


Long: 123° 22' 25"

A DCSO BRASS CAP STAMPED; BRUM 1998; SET IN A SMALL ROCK LEDGE APPROX. 3 FT ABOVE PAVEMENT.

Comments:

FROM THE INTERSECTION OF FISHER ROAD;
CO. RD 189; AND THE EASTERLY END OF RIVER
BEND RD; CO. RD 224; IN T26S R6W SEC.23;
PROCEED SOUTHEASTERLY ALONG FISHER
ROAD 0.2 MILES TO MONUMENT ON RIGHT.

Notes:

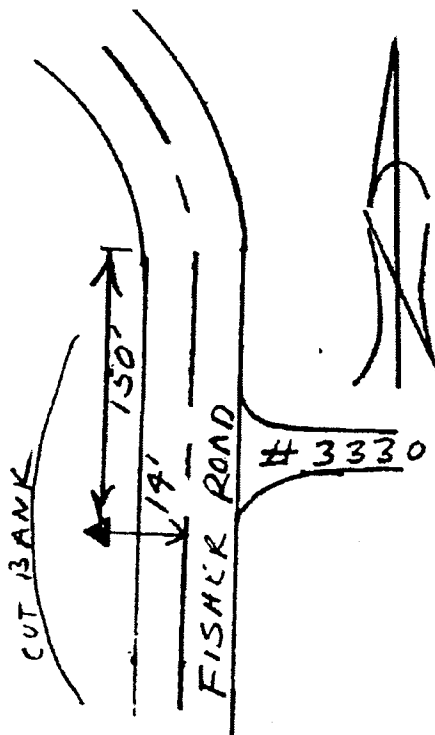

Note: For further information contact the Douglas County Surveyors Office, Room 105A Douglas County Courthouse, Roseburg, OR 97470. Phone 440-4272 or Fax (541)957-8150. Douglas County Residents outside Roseburg calling area, dial toll free 1-800-224-1619.