

Station: BOOMER

T 28 S, R 6W, Sec 3



Date Set: 1997

Set By (Agency): DCPW

Date Recovered: 6-15-98

Recovered By: RVS SJF

B-149

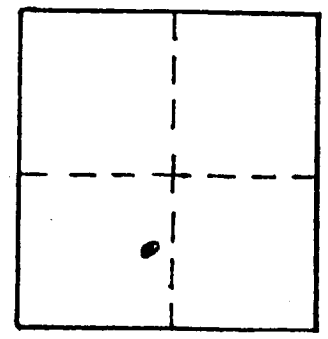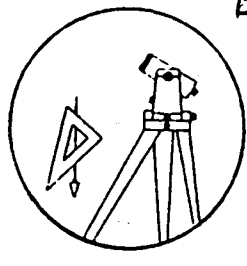

- Found
- New
- Reset
- Not Found
- Referenced
- Destroyed

VERTICAL CONTROL NGVD 29

Elevation: 493.132 NGS Line # _____ USGS Line # _____ OSHD Line # _____

Precision: 2nd Agency: DCSO Proj. # 2007 Date: 1998

HORIZONTAL CONTROL CORPSCON6 NAVD88 496.57 FT. CS66/66

South Zone O.C.S. 27: Y(Northing) _____ X(Easting) _____

South Zone O.C.S. 83: Y(Northing) 557910 X(Easting) 4148680

Precision: GIS SCALED Agency: DCSO Proj. # _____ Date: 2014

Approx. NAD ⁸³ Geographic Position: Latitude 43° 09' 39" Longitude 123° 23' 42"

DESCRIPTION and TO REACH

GO TO THE CONCRETE BRIDGE OVER THE SOUTH
UNIPPA RIVER IN GREEN ON HAPPY VALLEY ROAD,
IN T28S R6W SEC. 3.

A DCPW BRASS CAP NEAR SOUTH WEST CORNER
OF BRIDGE ON TOP OF CONCRETE RAIL, STAMPED
" BOOMER 1998 "

Reference Marks:

