


OFFICE OF THE
DOUGLAS COUNTY SURVEYOR


Station: BIG
 Date Set: ?
 Set By (Agency): DCPW
 Date Recovered: 11-4-98
 Recovered By: RWS, SJF

T 26 S, R 6W, Sec 20

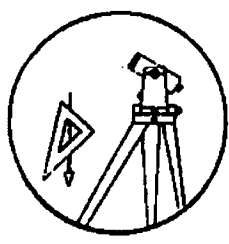

B-151

- Found
- Reset
- Referenced
- New
- Not Found
- Destroyed

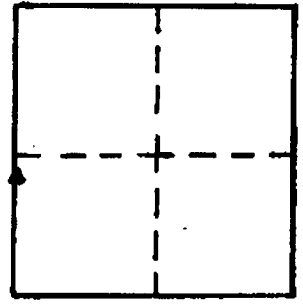

VERTICAL CONTROL NGVD 29 CORPCON 6 NAVD 88 411.18 FT
 Elevation: 407.72 NGS Line # _____ USGS Line # _____ OSHD Line # _____

Precision: 3rd Agency: DCSO Proj. # 2007 Date: 1998
 CS File # 661026

HORIZONTAL CONTROL
 South Zone O.C.S. 27: Y(Northing) _____ X(Easting) _____
 South Zone O.C.S. 83: Y(Northing) _____ X(Easting) _____
 Precision: _____ Agency: _____ Proj. # _____ Date: _____
 Approx. NAD 83 Geographic Position: Latitude _____ Longitude _____

DESCRIPTION and TO REACH

DCPW BRASS CAP SET IN CONCRETE
MONUMENT WE STAMP "BIG 1998"

GO TO THE INTERSECTION OF GARDEN VALLEY
RD (CO. RD #6) AND BIG BEND RD
(CO. RD #220) IN T26S R6W SEC 20
MONUMENT IS AT NORTHWEST CORNER OF
INTERSECTION

Reference Marks:

