


Douglas County Geodetic Data Sheet

Station: BLISTER
 Date Set: 1999 Set By (Agency): DCSO
 Last Date Recovered: 06/21/1999

Designation: B-155

T 26 R 05 WS 23

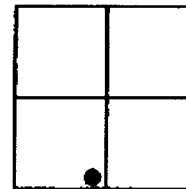

VERTICAL CONTROL

NGVD 29 Elevation: 607.56 Feet
 Precision: 3RD ORDER Agency: DCSO

CS File: 66025

Date: 1999

NAVD 88 Elevation: 611.08 ^{Feet} Meters
 Precision: CORPCON 6 Agency:
 NAVD 88

CS File:

Date:

HORIZONTAL CONTROL

OCS 27	Y(Northing):	X(Easting):	Lat 43° 17' 15.7"	Long: 123° 15' 21.9"
Precision:	GIS	Agency:	CS File: 66025	Date:
OCS 83	Y(Northing):	X(Easting):	Lat	Long:
Precision:	Agency:		CS File:	Date:
OCS 83/91	Y(Northing):	X(Easting):	Lat 43° 17' 15.1"	Long: 123° 15' 26.1"
Precision:	GIS	Agency:	CS File: 66025	Date:
OCS 83/98	Y(Northing):	X(Easting):	Lat	Long:
Precision:	Agency:		CS File:	Date:

Scaled Lat 43° 17' 16" Long: 123° 15' 22"


Description:

DCSO DISK STAMPED - BLISTER 1999 - SET IN A 4X6 FT CONCRETE POWER BOX FOOTING

Comments:

FROM THE INTERSECTION OF NORTH BANK RD;
 CO RD 200 AND ECHO BEND RD; CO RD 336 IN
 T26S R5W SEC 23 - PROCEED SOUTHWESTERLY
 ALONG ECHO BEND RD 0.25 MILES TO
 MONUMENT ON LEFT.

Notes:

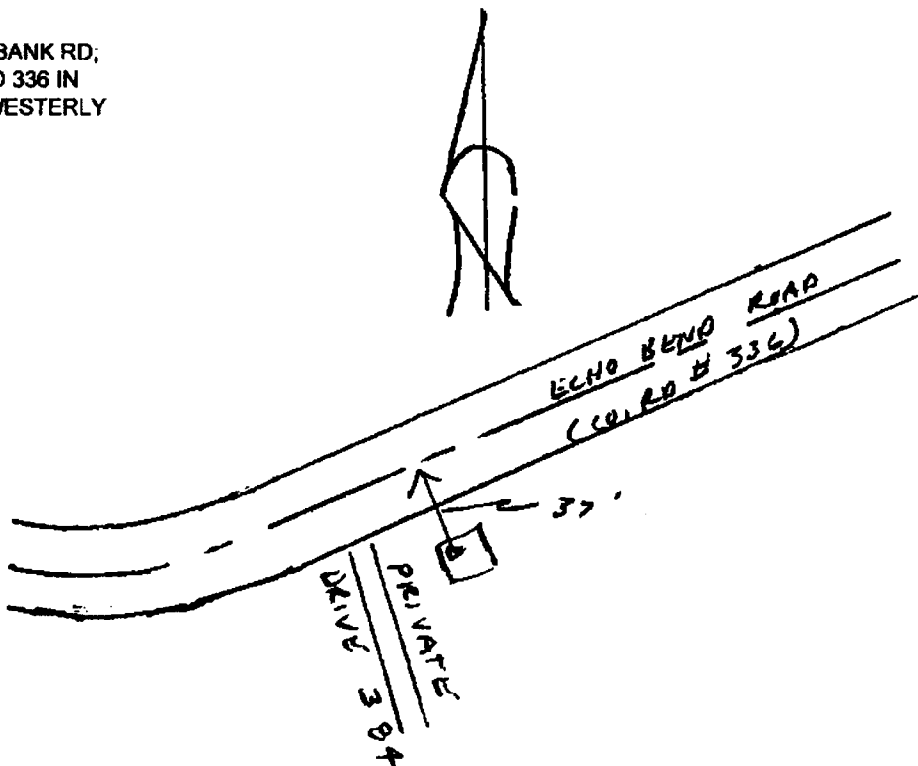

Note: For further information contact the Douglas County Surveyors Office, Room 105A Douglas County Courthouse, Roseburg, OR 97470. Phone 440-4272 or Fax (541)957-8150. Douglas County Residents outside Roseburg calling area, dial toll free 1-800-224-1619.