

REPORTED AS DESTROYED 1/31/2023

OFFICE OF THE
DOUGLAS COUNTY SURVEYOR

Station: BP


T 30 S, R 5W, Sec 34

Date Set: 1-5-1999

Set By (Agency): DCSO


Date Recovered: 1-6-1999

Recovered By: RNS SJF

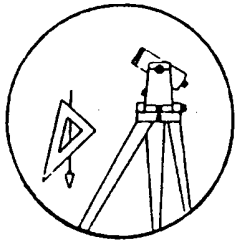

B-157

- Found
- New
- Reset
- Not Found
- Referenced
- Destroyed

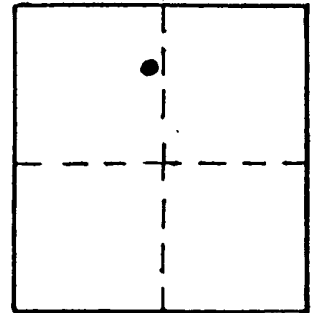

VERTICAL CONTROL CORPSCON6 NAVDBB 760.62 FT.

Elevation: 757.23 NGS Line # _____ USGS Line # _____ OSHD Line # _____

Precision: 3rd Agency: DCSO Proj. # 2007 Date: 1999

HORIZONTAL CONTROL

South Zone ~~O.C.S. 27~~: Y(Northing) _____ X(Easting) _____

South Zone O.C.S. 83: Y(Northing) 470963 X(Easting) 4177241

Precision: GIS SCALED Agency: DCSO Proj. # _____ Date: 2014

Approx. NAD 83 Geographic Position: Latitude 42° 55' 30" Longitude 123° 16' 39"

DESCRIPTION and TO REACH

A DCSO BRASS CAP STAMPED "BP 1999"
SET IN CONCRETE CURB.

GO TO THE INTERSECTION OF FREEWAY ON - OFF
RAMP AT 5TH STREET
IN CANYON VILLE.

Reference Marks:

