

Station: BETHEA


T 28S, R 6W, Sec 3

Date Set: 1999

Set By (Agency): DCSO


Date Recovered: 9-30-99

Recovered By: RWS SJF

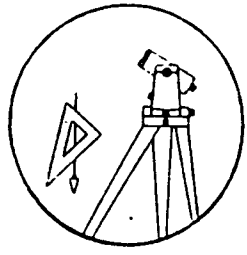

B-161

- Found
- Reset
- Referenced
- New
- Not Found
- Destroyed

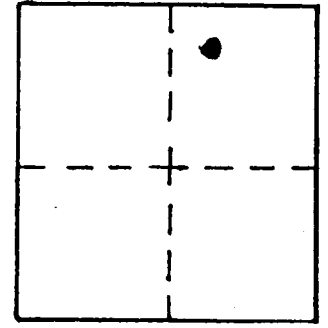

VERTICAL CONTROL

Elevation: 479.69 NGS Line # \_\_\_\_\_ USGS Line # \_\_\_\_\_ OSHD Line # \_\_\_\_\_

Precision: 3rd Agency: DCSO Proj. # 2007 Date: 1999

HORIZONTAL CONTROL CORPSCOMB NAVD88 483.14 FT. CS 66/44

South Zone O.C.S. 27: Y(Northing) \_\_\_\_\_ X(Easting) \_\_\_\_\_

South Zone O.C.S. 83: Y(Northing) 561035 X(Easting) 4149968

Precision: GIS SCALED Agency: DCSO Proj. # \_\_\_\_\_ Date: 2014

Approx. NAD 83 Geographic Position: Latitude 43 10 11 Longitude 123 23 26

DESCRIPTION and TO REACH

DCSO DRILL CAP SET IN CONCRETE DRIVE WAY, STAMPED "BETHEA 1999"

FROM THE INTERSECTION OF HAPPY VALLEY ROAD (CO. RD # 26) AND LITTLE VALLEY ROAD (CO. RD # 186) IN T28S R6W SEC. 3, PROCEED NORTHERLY ALONG LITTLE VALLEY ROAD 0.90 MILES TO MONUMENT ON RIGHT.

Reference Marks:

