

OFFICE OF THE
DOUGLAS COUNTY SURVEYOR

Station: BUBBA


T 26 S, R 3W, Sec 29

Date Set: 1999

Set By (Agency): DCSO


Date Recovered: 6-30-99

Recovered By: RWS SJF

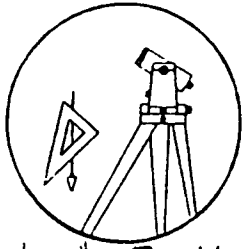

Designation # B-163

- Found
- New
- Reset
- Not Found
- Referenced
- Destroyed

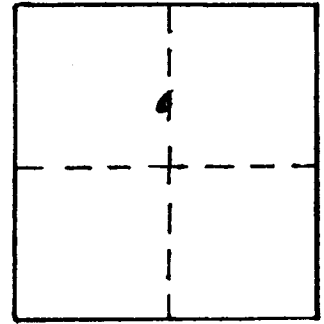

VERTICAL CONTROL

Elevation: 744.33 NGS Line # _____ USGS Line # _____ OSHD Line # _____

Precision: 3rd Agency: DCSC Proj. # 2007 Date: 1999

HORIZONTAL CONTROL CORPSCON6 NAVD88 747.9 FT. CS 66/56

South Zone O.C.S. 27: Y(Northing) _____ X(Easting) _____

South Zone O.C.S. 83: Y(Northing) 598924 X(Easting) 4234335

Precision: GIS SCALED Agency: DCSO Proj. # _____ Date: 2014

Approx. ⁰⁵²⁷~~NAD 83~~ Geographic Position: Latitude 43°16'51" Longitude 123°04'44"

DESCRIPTION and TO REACH

DCSO BRASS CAP STAMPED "BUBBA 1999" 3 FT
OIA. ROCK OUTCROP.

From THE INTERSECTION OF LITTLE RIVER ROAD
(CO. RD 17C) AND BUCK HORN ROAD (WHD 17)
IN T26 S R 3 W SEC. 30 PROCEED
SOUTHWESTWARD ALONG LITTLE RIVER ROAD 0.55 MILES
TO MONUMENT ON LEFT.

Reference Marks:

