

GIS

DOUGLAS COUNTY SURVEYOR'S OFFICE

R012222B

Designation: B-173 Station: BUCK-6 T 27S R 4W S 21 1/4 SW


Date Set: ?

Set by (Agency): DCPW

Date Recovered: 1-22-03

Recovered by: RUS SJF

- Found
- Not Found
- New
- Referenced
- Reset
- Destroyed

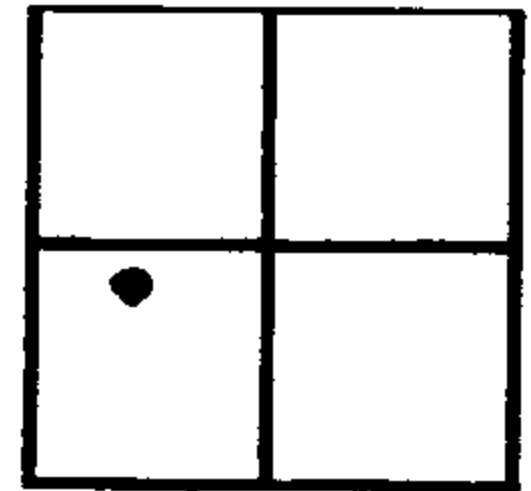

VERTICAL CONTROL

NGVD 29 Elevation: 768.30 Feet

File # CS66/63

Precision: 3rd

Agency: DCSO

Project: 2007

Date: 2003

NAVD 88 Elevation: 771.86 Meters

File # _____

Precision: CORCONG
NAVD 88

Agency: _____

Project: _____

Date: _____

HORIZONTAL CONTROL - south zone

N _____	E _____	Datum/Adj.: <u>1927</u>	Precision: <u>GIS</u>
Lat: <u>43° 12' 18.6"</u>	Long: <u>123° 10' 49.1"</u>	Agency: <u>DCSO</u>	File # <u>R012222B</u> Date: <u>2003</u>
N _____	E _____	Datum/Adj.: _____	Precision: _____
Lat: _____	Long: _____	Agency: _____	File # _____ Date: _____
N _____	E _____	Datum/Adj.: _____	Precision: _____
Lat: _____	Long: _____	Agency: _____	File # _____ Date: _____
N _____	E _____	Datum/Adj.: _____	Precision: _____
Lat: _____	Long: _____	Agency: _____	File # _____ Date: _____

DESCRIPTION AND TO REACH

DCSO BRASS CAP SET BY
DCPW SET IN SW CORNER
OF CONCRETE BRIDGE W/
STAMP "BUCK-6 2003"

FROM THE INTERSECTION OF
DIXONVILLE RD (CO. RD #164) AND
BUCK HORN RD (CO. RD #17) IN
T27S R5W SEC. 24 AT
DIXONVILLE PROCEED EASTERLY
ALONG BUCK HORN RD 3.2
MILE TO MONUMENT ON
RIGHT AT SE CORNER OF
CONCRETE BRIDGE.

