

GIS
R051922B

DOUGLAS COUNTY SURVEYOR'S OFFICE


17# 1153

Designation: B-185 Station: BOS-1 T 22S R 5W S 21 1/4 SW

Date Set: ? Set by (Agency): USGS

Date Recovered: 5-19-03 Recovered by: RWS SJF

- Found
- Not Found
- New
- Referenced
- Reset
- Destroyed

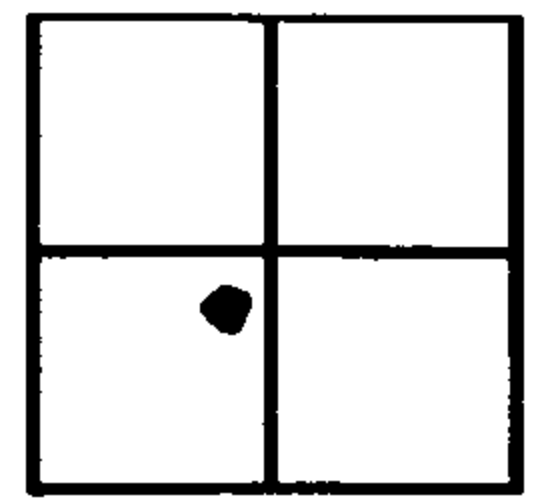

VERTICAL CONTROL

NGVD 29 Elevation: 329.28 Feet File # CS 67/3
 Precision: 3rd Agency: DCSO Project: 2007 Date: 2003
 NAVD 88 Elevation: 332.88 ^{FT} Meters File # _____
 Precision: CORPCON 6 Agency: _____ Project: _____ Date: _____
NAVD 88

HORIZONTAL CONTROL - south zone

N _____ E _____ Datum/Adj.: 1927 Precision: GIS
 Lat: 43° 38' 27.7" Long: 123° 17' 49.0" Agency: DCSO File # R051922B Date: 5/03
 N _____ E _____ Datum/Adj.: _____ Precision: _____
 Lat: _____ Long: _____ Agency: _____ File # _____ Date: _____
 N _____ E _____ Datum/Adj.: _____ Precision: _____
 Lat: _____ Long: _____ Agency: _____ File # _____ Date: _____
 N _____ E _____ Datum/Adj.: _____ Precision: _____
 Lat: _____ Long: _____ Agency: _____ File # _____ Date: _____

DESCRIPTION AND TO REACH

USGS BRONZE CAP SET AT
NORTH EAST CORNER OF CONCRETE
BRIDGE STAMPED "GAGING
STATION "WE STAMP" DCSO
BOS-1 2003"

FROM THE INTERSECTION OF
ENGLE VALLEY ROAD (CO. RD
#389) AND BOSWELL ROAD
(CO. RD #54) IN T22S R5W
SEC 21 PROCEED EASTERLY
ALONG BOSWELL ROAD 0.05
MILE TO MONUMENT ON
LEFT.

