

GIS
R051920A

DOUGLAS COUNTY SURVEYOR'S OFFICE


P# 1152

Designation: B-188 Station: BOS - 4 T 22S R 5W S 23 1/4 NW

Date Set: 2003 Set by (Agency): DCSO

Date Recovered: 5-15-03 Recovered by: RWS SJF

- Found New Reset
- Not Found Referenced Destroyed

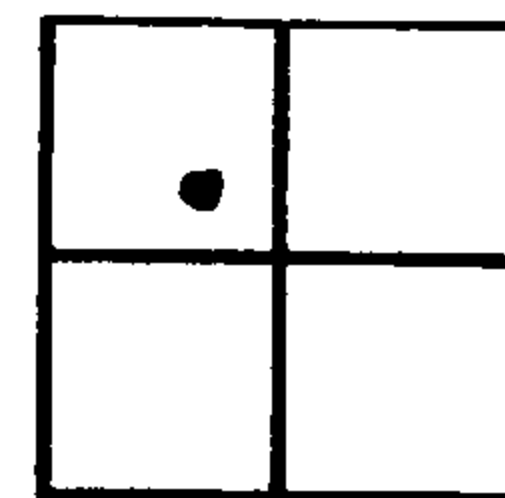

VERTICAL CONTROL

NGVD 29 Elevation: 341.75 Feet File # CS 67/3
 Precision: 3rd Agency: DCSO Project: 2007 Date: 2003

NAVD 88 Elevation: 345.36 ^{FT} Meters File # _____
 Precision: CORPCONG Agency: _____ Project: _____ Date: _____
NAVD 88

HORIZONTAL CONTROL - south zone

N _____ E _____ Datum/Adj.: 1927 Precision: GIS

Lat: 43° 38' 40.8" Long: 123° 15' 44.5" Agency: DCSO File # R051920A Date: 5/03

N _____ E _____ Datum/Adj.: _____ Precision: _____

Lat: _____ Long: _____ Agency: _____ File # _____ Date: _____

N _____ E _____ Datum/Adj.: _____ Precision: _____

Lat: _____ Long: _____ Agency: _____ File # _____ Date: _____

N _____ E _____ Datum/Adj.: _____ Precision: _____

Lat: _____ Long: _____ Agency: _____ File # _____ Date: _____

DESCRIPTION AND TO REACH

THE HEAD OF A BOLT
SPIKE STAMPED "BOS-4 2003"
CEMENTED ON TOP OF
CONCRETE BRIDGE SUPPORT,
3 FT BELOW BRIDGE SURFACE
FROM THE INTERSECTION OF
EAGLE VALLEY ROAD (CO. RD
#389 AND BOSWELL ROAD
(CO. RD #54) IN T22S R5W
SEC. 21 PROCEEDED EASTERLY
ALONG BOSWELL ROAD
2.15 MILE TO MONUMENT
ON RIGHT.

