

N^o
6's

DOUGLAS COUNTY SURVEYOR'S OFFICE


PH # 1140

Designation: B-189 Station: BOS-5 T 22S R 5W S 23 1/4 NE

Date Set: 2003 Set by (Agency): DCSO

Date Recovered: 5-15-03 Recovered by: RWS SJF

- Found New Reset
- Not Found Referenced Destroyed

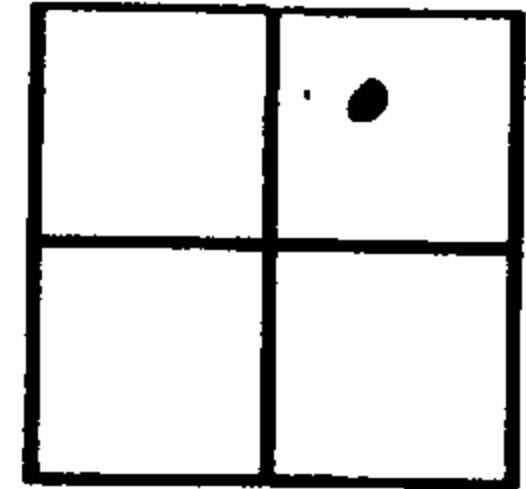

VERTICAL CONTROL

NGVD 29 Elevation: 364.39 Feet File # CS 67/3
 Precision: 3rd Agency: DCSO Project: 2007 Date: 2003
 NAVD 88 Elevation: 368.00 Meters File # _____
 Precision: CORPCON 6 Agency: _____ Project: _____ Date: _____
NAVD 88

HORIZONTAL CONTROL - south zone

N _____	E _____	Datum/Adj.: _____	Precision: <u>SCALED</u>
Lat: <u>43° 28' 50" N</u>	Long: <u>122° 15' 17" W</u>	Agency: _____	File # _____ Date: _____
N _____	E _____	Datum/Adj.: _____	Precision: _____
Lat: _____	Long: _____	Agency: _____	File # _____ Date: _____
N _____	E _____	Datum/Adj.: _____	Precision: _____
Lat: _____	Long: _____	Agency: _____	File # _____ Date: _____
N _____	E _____	Datum/Adj.: _____	Precision: _____
Lat: _____	Long: _____	Agency: _____	File # _____ Date: _____

DESCRIPTION AND TO REACH

DCSO DRILL CAP STAMPED
"BOS-5 2003" SET IN
ROCK OUT CROP 2 FT
ABOVE ROAD SURFACE.

FROM THE INTERSECTION OF
BOSWELL ROAD (CO. RD #54)
AND EAGLE VALLEY ROAD
(CO. RD #389) IN T22S R5W
SEC 21 PROCEED EASTERLY
ALONG BOSWELL ROAD
2.60 MILE TO MONUMENT ON
LEFT

