

615

RO51921C
OFFICE SOUTH 87' (133)
TO MON


DOUGLAS COUNTY SURVEYOR'S OFFICE PH 100-1138

Designation: B-195 Station: BOS-11 T 22S R 4W S 19 1/4 NW

Date Set: 2003 Set by (Agency): DCSO-

Date Recovered: 5-9-03 Recovered by: RWS SJF

- Found
- New
- Reset
- Not Found
- Referenced
- Destroyed

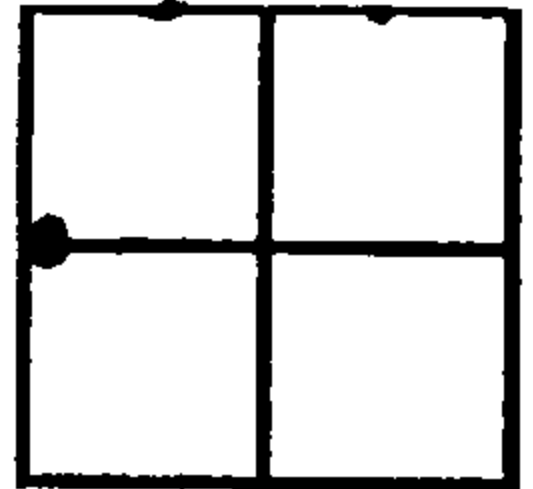

VERTICAL CONTROL

NGVD 29 Elevation: 380.22 Feet File # CS67/3
 Precision: 3rd Agency: DCSO Project: 2007 Date: 2003
 NAVD 88 Elevation: 383.85 ^{FT} Meters File # _____
 Precision: CORPCON 6 Agency: _____ Project: _____ Date: _____

HORIZONTAL CONTROL - south zone

N _____ E _____ Datum/Adj.: 1927 Precision: 615
 Lat: 43° 38' 32.4" Long: 123° 13' 36.3" Agency: DCSO File # CS 67/3 Date: 5/03
 N _____ E _____ Datum/Adj.: _____ Precision: _____
 Lat: _____ Long: _____ Agency: _____ File # _____ Date: _____
 N _____ E _____ Datum/Adj.: _____ Precision: _____
 Lat: _____ Long: _____ Agency: _____ File # _____ Date: _____
 N _____ E _____ Datum/Adj.: _____ Precision: _____
 Lat: _____ Long: _____ Agency: _____ File # _____ Date: _____

DESCRIPTION AND TO REACH

DCSO DRILL CAP STAMPED
"BOS-11 2003" SET IN NE
WINGWALL OF CONCRETE BRIDGE
FROM THE INTERSECTION OF
BOSWELL ROAD (CO. RD #54) AND
ANLAUF RD (CO. RD #25) N
T22S R4W SEC 30, PROCEED
NORTHWESTERLY ALONG BOSWELL
ROAD 0.95 MILES TO
MONUMENT ON RIGHT

