

CIS
R050819A

DOUGLAS COUNTY SURVEYOR'S OFFICE

PH 100-1137

Designation: B-197 Station: BOS-13 T 22S R 4W S 30 1/4 SW


Date Set: 2003

Set by (Agency): DCSO

Date Recovered: 5-9-03

Recovered by: RWS-SJF

- Found
- New
- Reset
- Not Found
- Referenced
- Destroyed

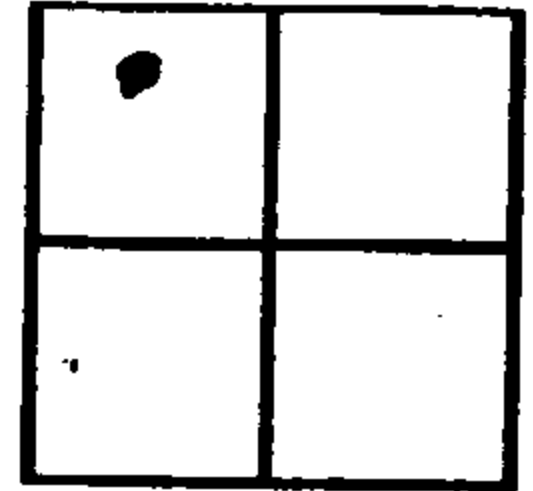

VERTICAL CONTROL

NGVD 29 Elevation: 388.01 Feet

File # CS 6713

Precision: 3rd

Agency: DCSO

Project: 2007

Date: 2003

NAVD 88 Elevation: 391.64 Meters

File # _____

Precision: CORPCON 6

Agency: _____

Project: _____

Date: _____

HORIZONTAL CONTROL - south zone

N _____ E _____ Datum/Adj.: 1927

Precision: 615

Lat: 43° 37' 58.0" Long: 123° 13' 17.4" Agency: DCSO

File # R050819A Date: 5/03

N _____ E _____ Datum/Adj.: _____

Precision: _____

Lat: _____ Long: _____ Agency: _____

File # _____ Date: _____

N _____ E _____ Datum/Adj.: _____

Precision: _____

Lat: _____ Long: _____ Agency: _____

File # _____ Date: _____

N _____ E _____ Datum/Adj.: _____

Precision: _____

Lat: _____ Long: _____ Agency: _____

File # _____ Date: _____

DESCRIPTION AND TO REACH

DCSO DRILL CAP STAMPER
"BOS-13 2003" SET IN SE
WINGWALL OF CONCRETE
BRIDGE.

FROM THE INTERSECTION OF
BUSWELL ROAD (CO. RD #54)
AND ANLAUF RD (CO. RD #25)
IN T22S R4W SEC 30,
PROCEED NORTHEASTERLY ALONG
ANLAUF ROAD 0.1 MILES TO
CONCRETE BRIDGE AND MONUMENT
ON RIGHT.

