



OFFICE OF THE
DOUGLAS COUNTY SURVEYOR

C-003
PID:

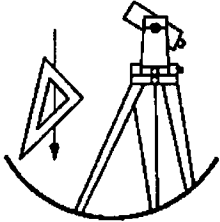

Station: C 10
Date Set: 1920
Set By (Agency): USC & GS
DCSO Designation: C-003
Date Recovered: 8-29-94 ; 10/98
Recovered By: RWS-SJF
Date Recovered: _____
Recovered By: _____
Date Recovered: _____
Recovered By: _____

T27S R6W Sec. 13

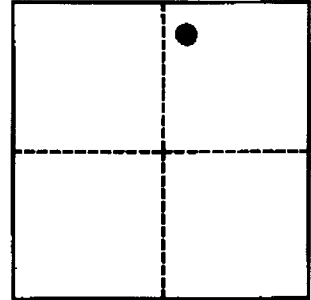

VERTICAL CONTROL

NGVD 29 Elevation: 471.039 FEET NAVD 88 Elevation: 144.631 METERS
NGS Line # 6 & L250035 USGS LINE # _____ OSHD Line # _____ FILE # CS 66/46 (10/98)
Precision: 1ST ORDER Agency: USC & GS Proj: _____ Date: 1957, 1988
SEE NGS WEB FOR 88 ELEVATION


NAVD 88 474.511 FT

HORIZONTAL CONTROL

O.C.S. 27 Y(Northing): 581,905.45 O.C.S. 83 Y(Northing): 581,870.28
(South Zone) X(Easting): 1,239,717.87 (South Zone) X(Easting): 4,160,676.17
Precision: 1/25,000 Agency: DCSO Proj: 2005-2 Date: 1983
Approx. O.C.S. 27 Geographic Position: Latitude: 43°13'40" Longitude: 123°21'12"
Approx. O.C.S. 83 Geographic Position: Latitude: 43°13'40" Longitude: 123°21'16"

Found: A USC & GS disk stamped "ELEV 470.396 FT C 10 1920" set flush in a concrete culvert headwall.

To Reach: From the intersection of Garden Valley Blvd. and Airport Rd. in T27S R6W Sec. 3, proceed northerly along Airport Rd. 0.1 mi. to the monument on the left.

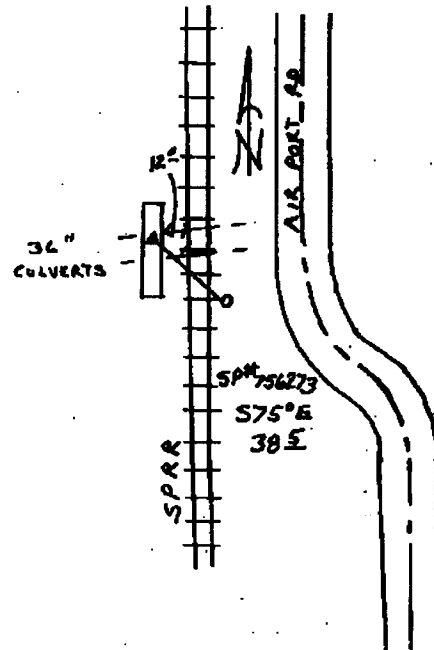

Note: For further information contact the Douglas County Surveyors Office, Room 205 Douglas County Justice Building, Roseburg, OR 97470. Phone 440-4272. Douglas County Residents outside Roseburg calling area, dial toll free 1-800-477-0991.