

OFFICE OF THE
DOUGLAS COUNTY SURVEYOR

C-014



C-014
C-109 RESET

32S 6W 25

NAD 410752.65 4152153.44
83 42°45'27" 123°21'52"

Station: C-109 Reset T 32 S, R 6W, Sec 25

Set By (Agency): DCSO

Date Set: 1973 Reset 1978

Recovered By JP-RWS


Date Recovered 2-9-82

Recovered By JP-RWS

Date Recovered _____

Recovered By _____

Date Recovered _____

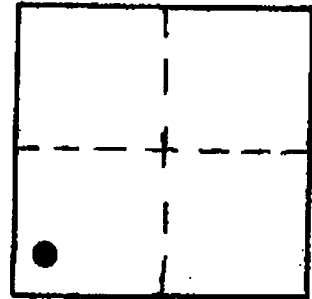

VERTICAL CONTROL

CORPCON 6 NAVD 88 1480.329 FT

Elevation: 1476.946 NGS Line # _____ USGS Line # _____ OSHD Line # _____

Precision: 2nd Agency: DCSO Proj. # 2006 Date: 1973

HORIZONTAL CONTROL

South Zone State Plane Coordinates: Y(Northing) 410,788.74 X(Easting) 1,231,194.83

Precision: 1/25,000 Agency: DCSO Proj. # 2006 Date: 1973


Approximate Geographic Position: Latitude 42°45'28" Longitude 123°21'48"

DESCRIPTION and TO REACH

SKETCH

Found: A standard DCSO disk stamped "C-109 1973 Reset 1978." Station is set flush on a 1' x 4' headwall for culvert and is 2.0 ft. below the surface of the road.

To reach: From the Glendale - I-5 interchange proceed Northerly on Fortune Branch Access Rd. (Co.Rd. #12A) to junction with Fortune Branch Rd. (Co.Rd. #12) in T32S R6W sec. 26. Turn right and proceed Easterly on Fortune Branch Rd. (Co.Rd. #12) 0.55 miles to station on the left.

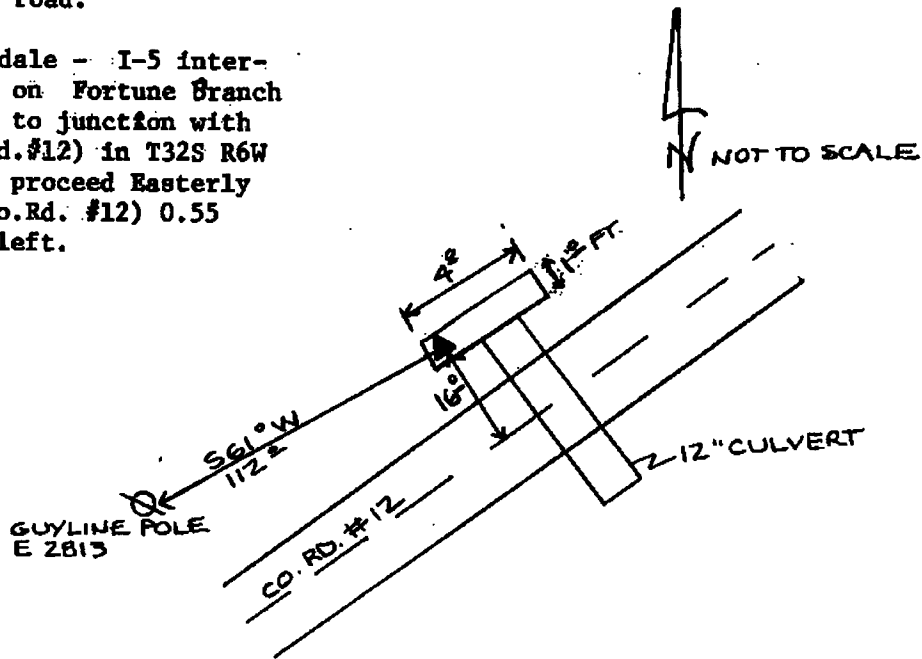

Reference Marks:

Note: For further information, contact the Douglas County Surveyor's Office, Room 205 Douglas County Justice Building, Roseburg, OR 97470. Phone 440-4278. Douglas County residents outside the Roseburg calling area, dial toll free 1-800-452-0991.