

OFFICE OF THE  
DOUGLAS COUNTY SURVEYOR

C-018




C-018  
C-113

32S 5W 15

NAD 420570.89 4177342.49  
83 42°47'13" 123°16'19"

Station: C-113 T 32 S, R 5W , Sec 15  
Set By (Agency): DCSO  
Date Set: 1973  
Recovered By LEM-TP  
Date Recovered 6-16-81  
Recovered By RWS,SJF  
Date Recovered 10/21/85  
Recovered By \_\_\_\_\_  
Date Recovered \_\_\_\_\_

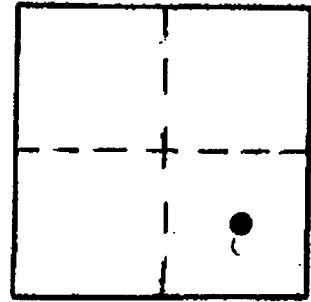

VERTICAL CONTROL CORPCON 6 NAVD 88 1603.946 FT

Elevation: 1600.565 NGS Line # \_\_\_\_\_ USGS Line # \_\_\_\_\_ OSHD Line # \_\_\_\_\_  
Precision: 2nd Agency: DCSO Proj. # 2006 Date: 1975

HORIZONTAL CONTROL


South Zone State Plane Coordinates: Y(Northing) 420,607.12 X(Easting) 1,256,383.80  
Precision: 1/25,000 Agency: DCSO Proj. # 2006 Date: 1973  
Approximate Geographic Position: Latitude 42°47'13" Longitude 123°16'15"

DESCRIPTION and TO REACH

SKETCH

Found: A standard DCSO disk stamped "C-113 1973". Disk is set in a 6" diam. concrete belltile. Station mark is 23 ft. N'Westly of centerline Co. Rd. #12.

To reach: From the intersection of I-5 and Co. Rd. #12 (Exit No 88) (Fortune Branch Rd.) continue on Co. Rd. #12, 1 mile to station on the right.

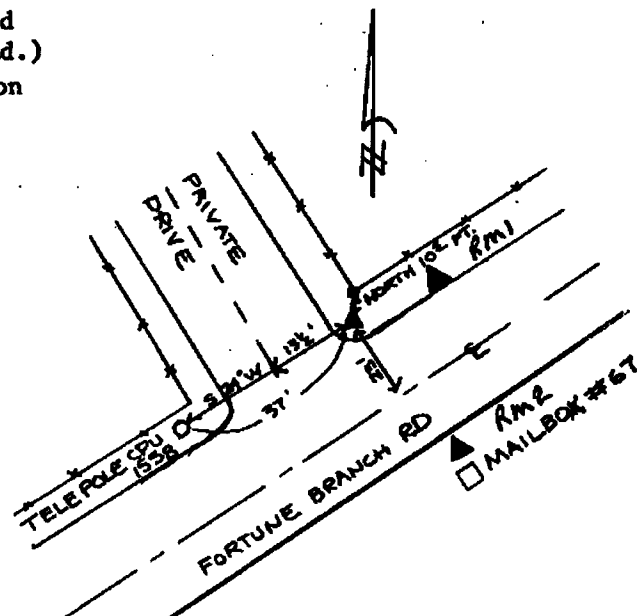

Reference Marks: (Proj. #2013)

A DCSO disk stamped "C-113 RM 1 1985"  
bears N 30°53'58" E, 34.93 ft. (grid) elev. 1601.987 ft.

A DCSO disk stamped "C-113 RM 2 1985"  
bears S 55°13'04" E, 46.91 ft. (grid) elev. 1599.301 ft.

Note: For further information, contact the Douglas County Surveyor's Office, Room 205 Douglas County Justice Building, Roseburg, OR 97470. Phone 440-4278. Douglas County residents outside the Roseburg calling area, dial toll free 1-800-452-0991.