



OFFICE OF THE
DOUGLAS COUNTY SURVEYOR

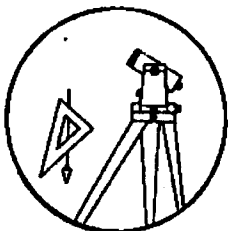

Station: C 247. C044 T 22 S, R 9W , Sec 18
Set By (Agency): OSHD
Date Set: 1929
Recovered By GQ-TP
Date Recovered 2-17-82
Recovered By _____
Date Recovered _____
Recovered By _____
Date Recovered _____

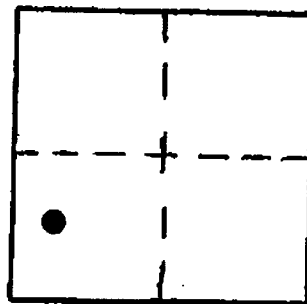


VERTICAL CONTROL CORPCON 6 NAVD 88 53,316 FT
Elevation: 49.757 NGS Line # 16 USGS Line # _____ OSHD Line # _____
Precision: 1st Agency: USC&GS Proj. # _____ Date: 1961

HORIZONTAL CONTROL
South Zone State Plane Coordinates: Y(Northing) _____ X(Easting) _____
Precision: _____ Agency: _____ Proj. # _____ Date: _____
Approximate Geographic Position: Latitude _____ Longitude _____

DESCRIPTION and TO REACH

Found: A standard OSHD disk set in the end of bridge curb stamped "C247 ELEV. 49 ft. 1929".

To reach: From the intersection of Hwy. 38 & Co. Rd. #240 (in sec. 18 T22S R9W) proceed westerly along Hwy. 38 150 ft. to end of bridge approach and monument on the right.

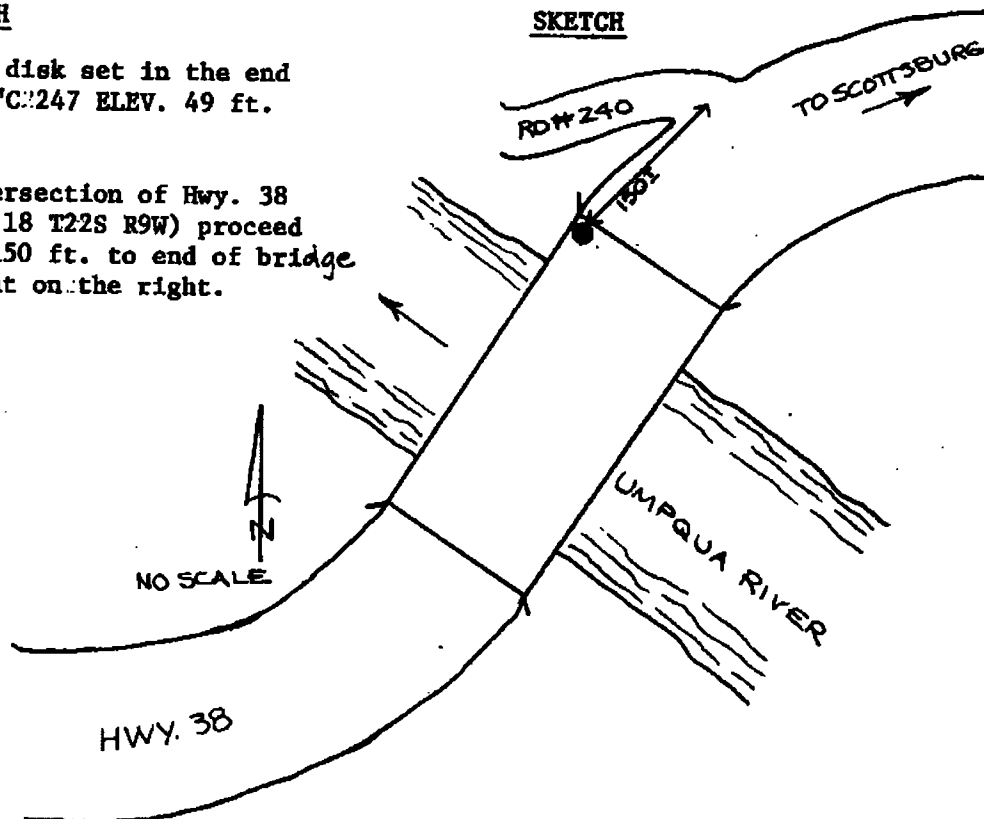

Reference Marks:

Note: For further information, contact the Douglas County Surveyor's Office, Room 205 Douglas County Justice Building, Roseburg, OR 97470. Phone 440-4278. Douglas County residents outside the Roseburg calling area, dial toll free 1-800-452-0991.