



OFFICE OF THE
DOUGLAS COUNTY SURVEYOR

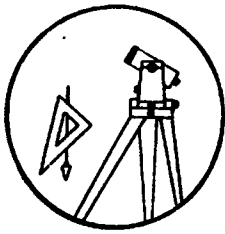

Station: C 499 T 30 S, R 6W , Sec 1
 Set By (Agency): USC&GS
 Date Set: 1949
 Recovered By LEM-JMP
 Date Recovered 2-25-82
 Recovered By _____
 Date Recovered _____
 Recovered By _____
 Date Recovered _____

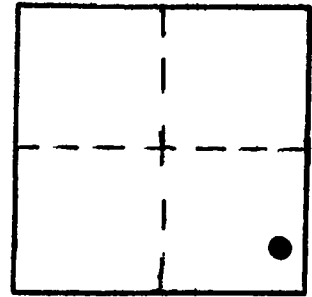

C048

VERTICAL CONTROL NGVD 29 CORCON 6 NAVD 88 676.572 FT
 Elevation: 673.138 NGS Line # 130 USGS Line # _____ OSHD Line # _____
 Precision: 2nd Agency: USC&GS Proj. # _____ Date: 1957


HORIZONTAL CONTROL
 South Zone State Plane Coordinates: Y(Northing) _____ X(Easting) _____
 Precision: _____ Agency: _____ Proj. # _____ Date: _____
 Approximate Geographic Position: Latitude _____ Longitude _____

DESCRIPTION and TO REACH

Found: A standard USC&GS disk stamped "C 499 1949" set in a concrete headwall. Station mark is approx. 4 ft. lower than the S.P.R.R. tracks.

To reach: From the intersection of Co.Rd. #'s 20A, 20, 263, and 41 in T30S R6W sec. 12 proceed Northerly along Co.Rd. #41 (Weaver Rd.) 1.0 mi. to station approx. 150 ft. to the right.

SKETCH LEGEND
 ▲ MONUMENT
 ○ - SIGNAL STATION

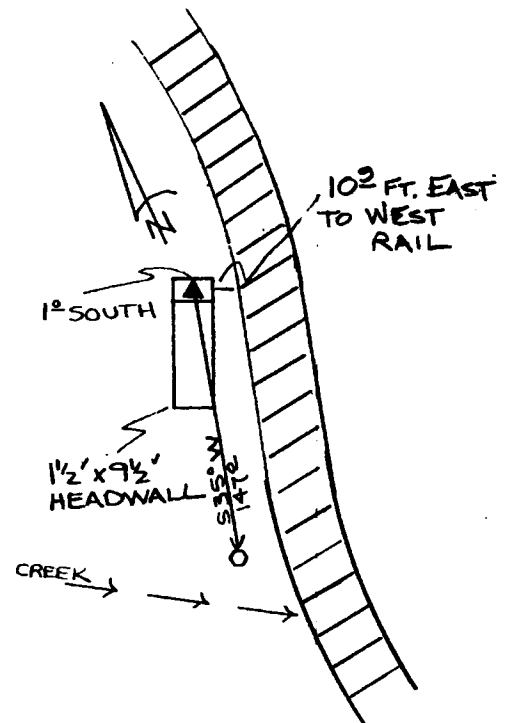

Reference Marks:

Note: For further information, contact the Douglas County Surveyor's Office, Room 205 Douglas County Justice Building, Roseburg, OR 97470. Phone 440-4278. Douglas County residents outside the Roseburg calling area, dial toll free 1-800-452-0991.