

Date Set: 1985

Set By (Agency): DCSO

DCSO Designation: C-057

Date Recovered: March 4, 1985



Recovered By: JRL SJF, RWS

Date Recovered: _____

Recovered By: _____

Date Recovered: _____

Recovered By: _____

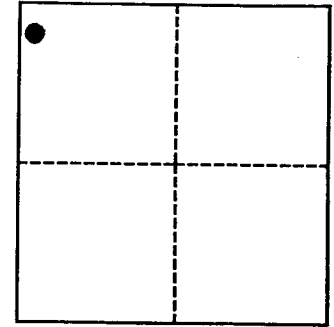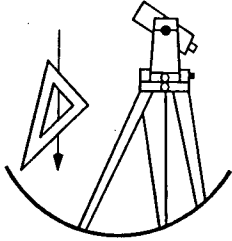

VERTICAL CONTROL

NGVD 29 Elevation: 565.182 FEET

CORPSCON6
NAVD 88 Elevation: 568.625 FT.

NGS Line # _____ USGS LINE # _____

OSHD Line # _____ FILE # _____

Precision: 2ND ORDER Agency: DCSO Proj: 2013 Date: 1985

CS66/61

HORIZONTAL CONTROL

O.C.S. 27 Y(Northing): _____

O.C.S. 83 Y(Northing): 556397

(South Zone) X(Easting): _____

(South Zone) X(Easting): 4126144

Precision: GIS SCALED Agency: DCSO Proj: _____ Date: 2014

Approx. O.C.S. 27 Geographic Position: Latitude: 43°09'18" Longitude: 123°28'45"

Approx. O.C.S. 83 Geographic Position: Latitude: _____ Longitude: _____

Description: A DCSO disk stamped "CALMEN 1985" set in middle of westerly head wall of bridge over tributary to Lookingglass Creek stamped "CALMEN 1985".

To reach: From the intersection of Brockway-Lookingglass Rd. (Co. Rd. #47) and Happy Valley Rd. (Co. Rd. #26) in T28S R6W Sec7, proceed northwesterly along Co. Rd. #47 approx. 1.2 miles to monument on left.

