


OFFICE OF THE
DOUGLAS COUNTY SURVEYOR

Station: CHINS. T 27 S, R 6W, Sec 24
 Set By (Agency): DCSO
 Date Set: 6/16/82
 Recovered By JP, TP
 Date Recovered 6/82
 Recovered By RMS-SJF/2000
 Date Recovered _____
 Recovered By _____
 Date Recovered _____

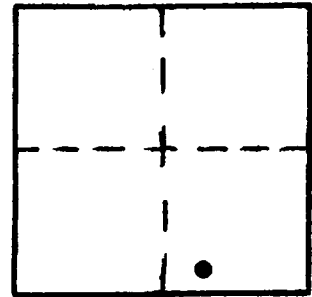

C-083
CHINS

27S 6W 24

NAD 571716.36 4160777.52
 83 43°11'59" 123°21'40"

VERTICAL CONTROL NGVD 29' "CORPCON 6 NAVD 88 492.34 FT
 Elevation: 488.87 NGS Line # _____ USGS Line # _____ OSHD Line # _____
 Precision: 3rd Agency: DCSO Proj. # 66/38 Date: 2000

HORIZONTAL CONTROL OCS 27
 South Zone State Plane Coordinates: Y(Northing) 571,751.56 X(Easting) 1,239,819.17
 Precision: 1/20,000 Agency: DCSO Proj. # 2005-2 Date: 1983
 Approximate Geographic Position: Latitude 43°12'00.1" Longitude 123°21'05.8"

DESCRIPTION and TO REACH


DESCRIPTION:

A DCSO disk stamped "CHINS 1982" set flush in a concrete road dividing island.

TO REACH:

Go to the island at the junction of SE Stephens St. and SE Pine St. in Roseburg.

SKETCH

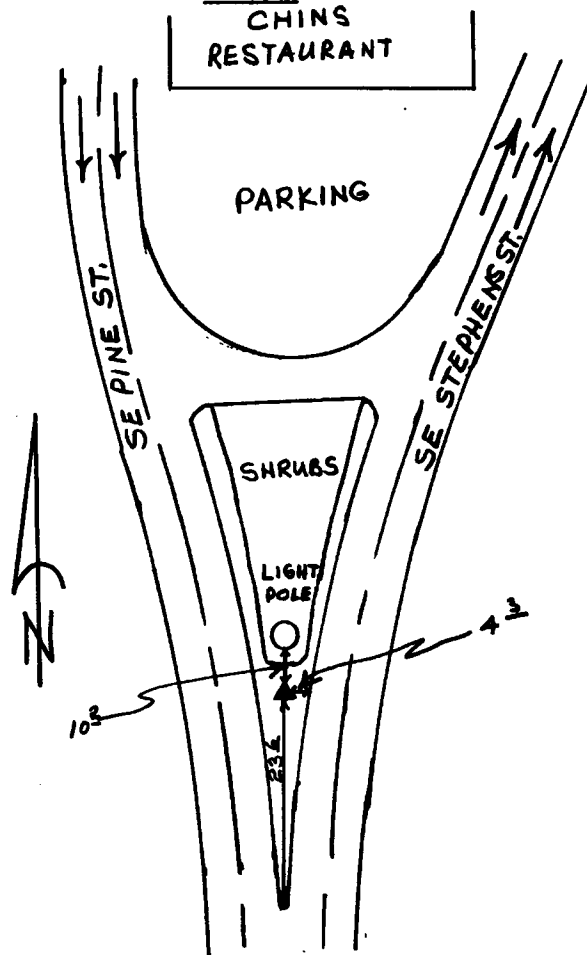

Reference Marks:

Note: For further information, contact the Douglas County Surveyor's Office, Room 205 Douglas County Justice Building, Roseburg, OR 97470. Phone 440-4278. Douglas County residents outside the Roseburg calling area, dial toll free 1-800-452-0991.