

OFFICE OF THE
DOUGLAS COUNTY SURVEYOR

Station: CO. RD. #8 CON. MON. #1 T 22 S, R 4 W , Sec 31

Set By (Agency): DCSO

Date Set: 1974

Recovered By RWS, SJF


Date Recovered 9/87

Recovered By RWS-SJF 1994

Date Recovered _____

Recovered By _____

Date Recovered _____

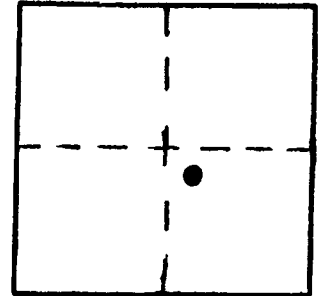

c-100 22S 4W 31
CON MON #1 (Co. Rd. #8)

NAD 721070.46 4202098.67
83 43°36'47" 123°12'58"

VERTICAL CONTROL NGVD 29 CORCON 6 NAVD 88 450.22 FT
Elevation: 446.59 NGS Line # _____ USGS Line # _____ OSHD Line # _____
Precision: 3rd Agency: DCSO Proj. # CS 66/54 Date: 1994

HORIZONTAL CONTROL
South Zone State Plane Coordinates: Y(Northing) 721,105.07 X(Easting) 1,281,138.25
Precision: 1/25,000 Agency: DCSO Proj. # cs 56/50, 2004-7 Date: 1974
Approximate Geographic Position: Latitude 43°36'48" Longitude 123°12'54"


DESCRIPTION and TO REACH

A DCSO disk stamped "CO.RD.#8 CON.MON.#1 1974" set in concrete in top of 3 inch diameter 18 inch long steel pipe set in concrete and protruding approximately 4 inches above ground.

TO REACH:

Monument is near east I-5 R/W fence and is approximately 800 feet northeasterly from the beginning of the Interstate Highway 5 northbound on-ramp for Scotts Valley Road (Co. Rd. #8) in T22S,R4W,Sec. 31.

SKETCH

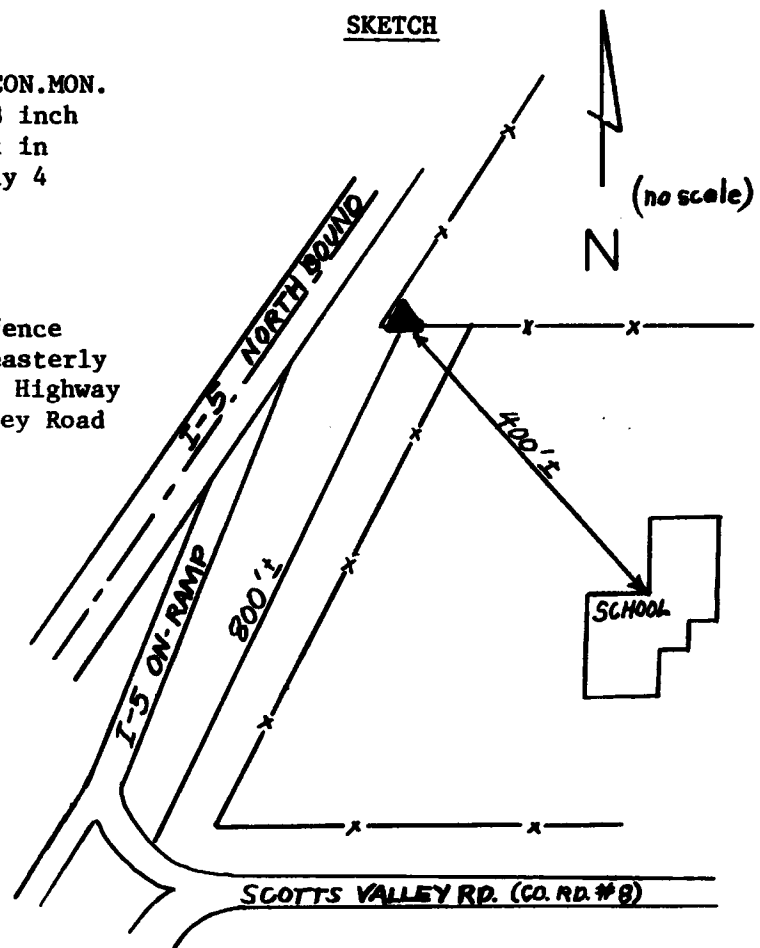

Reference Marks:

Note: For further information, contact the Douglas County Surveyor's Office, Room 205 Douglas County Justice Building, Roseburg, OR 97470. Phone 440-4278. Douglas County residents outside the Roseburg calling area, dial toll free 1-800-452-0991.