

OFFICE OF THE
DOUGLAS COUNTY SURVEYOR

Station: CAROL RESET

T 26 S, R 6 W , Sec 29

Set By (Agency): DCSO

Date Set: 1988

Recovered By RWS,SJF


Date Recovered 7/13/88

Recovered By RWS,TF

Date Recovered 12/27/88

Recovered By OK 11/9/98

Date Recovered _____

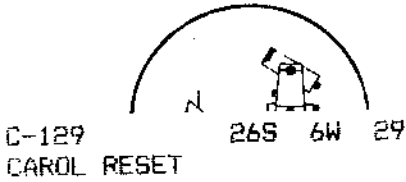

NAD 599785.74 4139063.89
83 43°16'29" 123°26'16"

VERTICAL CONTROL NGND 29

Elevation: 427.184 NGS Line # _____ USGS Line # _____ OSHD Line # _____

Precision: 2nd Agency: DCSO Proj. # 2007 Date: 1990

HORIZONTAL CONTROL OCS 27

South Zone State Plane Coordinates: Y(Northing) 599,820.78 X(Easting) 1,218,105.24

Precision: 1/25,000 Agency: DCSO Proj. # 2013 Date: 1988

Approximate Geographic Position: Latitude 43°16'30" Longitude 123°26'12"


DESCRIPTION and TO REACH

SKETCH

A DCSO disk stamped "CAROL RESET 1988" set in a 6 in. dia. 42 in. long concrete filled belltile protruding 3 in. above ground.

TO REACH:

From the intersection of Garden Valley Rd. (Co.Rd.#6) and River Forks Rd. (Co.Rd.#283) in T26S,R6W,Sec.29, proceed northerly along Garden Valley Rd. 0.1 miles to monument on left.

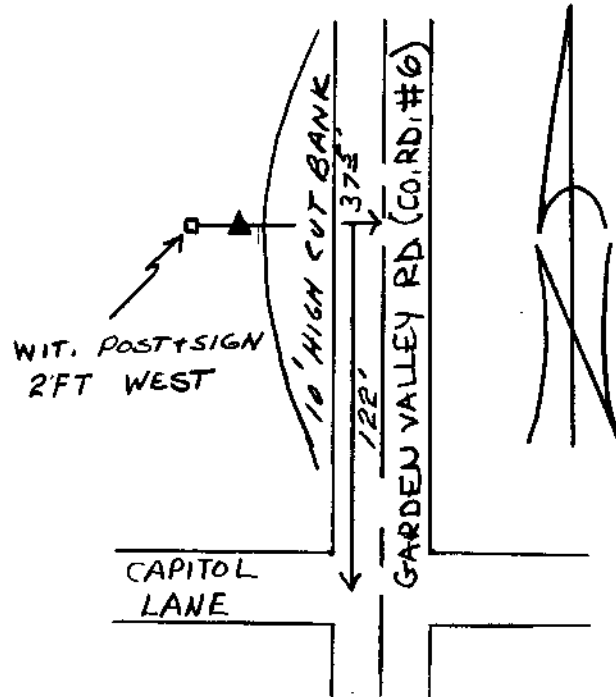

Reference Marks:

Note: For further information, contact the Douglas County Surveyor's Office, Room 205 Douglas County Justice Building, Roseburg, OR 97470. Phone 440-4278. Douglas County residents outside the Roseburg calling area, dial toll free 1-800-452-0991.