

OFFICE OF THE
DOUGLAS COUNTY SURVEYOR

Station: CHEV

T 30 S, R 5 W, Sec 7

Set By (Agency): OSHD

Date Set: 1988

Recovered By RWS, SJF


Date Recovered 1/4/89

Recovered By _____

Date Recovered _____

Recovered By _____

Date Recovered _____

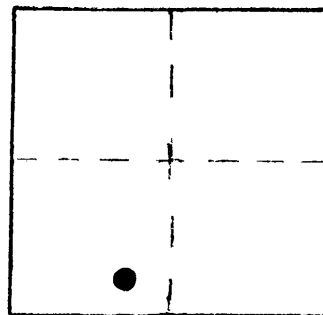

C-131
CHEV

NAD 489032.38 4162015.40
83 42°58'24" 123°20'16"

VERTICAL CONTROL

Elevation: _____ NGS Line # _____ USGS Line # _____ OSHD Line # _____

Precision: _____ Agency: _____ Proj. # _____ Date: _____

HORIZONTAL CONTROL **OCS 27**

South Zone State Plane Coordinates: Y(Northing) 489,068.04 X(Easting) 1,241,056.83

Precision: 1/25,000 Agency: DCSO Proj. # 2013 Date: 1989

Approximate Geographic Position: Latitude 42°58'24" Longitude 123°20'11"


DESCRIPTION and TO REACH

An OSHD 1 1/2 inch aluminium cap stamped "OREG. STATE HWY. DIV. CHEV 1988" set in concrete flush with pavement.

TO REACH:

Go to the Hwy. 99 overpass of I-5 (exit 103, Riddle-Tri City) in T30S,R5W,Sec.7, monument is in the triangle at the intersection of Hwy. 99 and the south bound onramp to I-5.

SKETCH

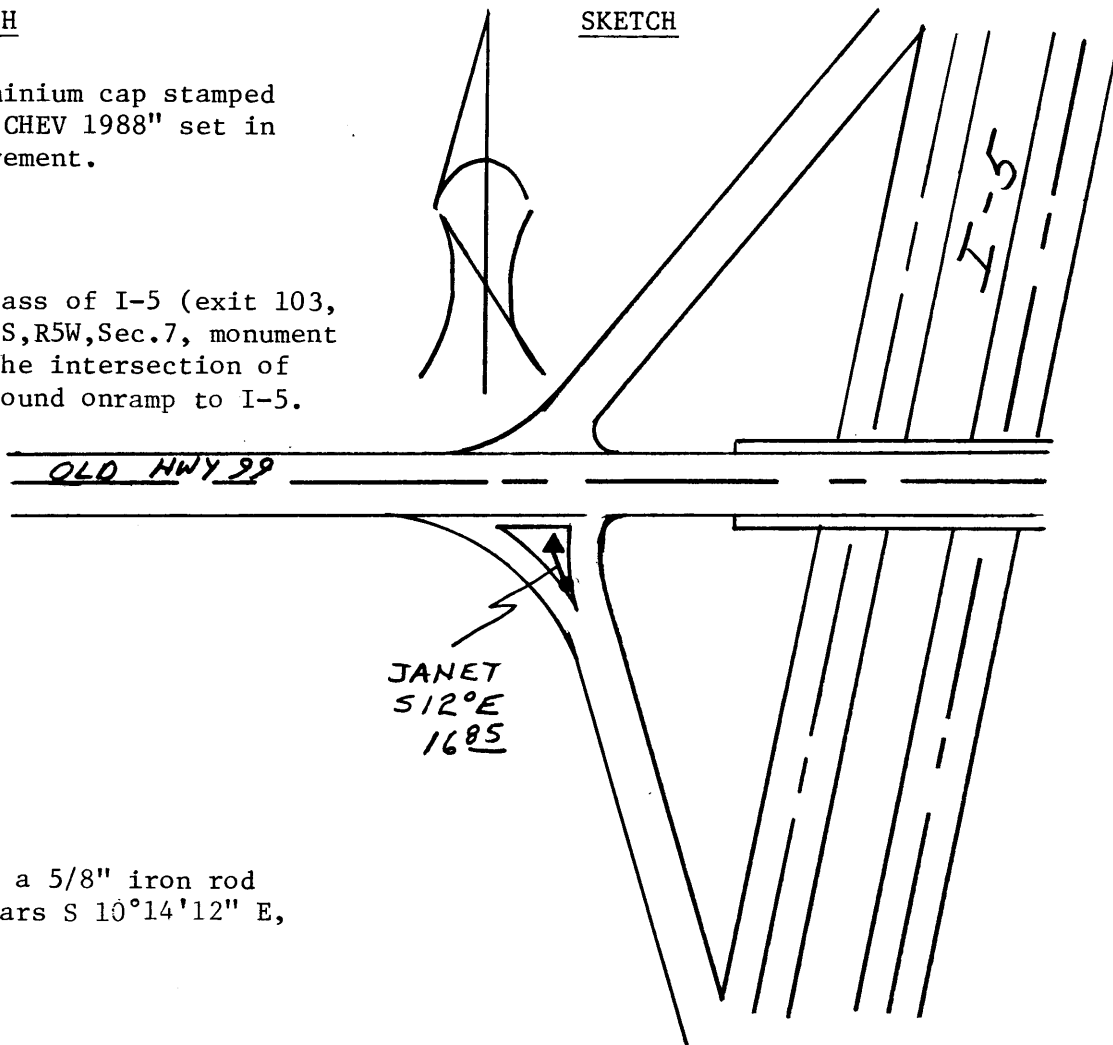

Reference Marks:

A DCSO aluminium cap on a 5/8" iron rod stamped "JANET 1978"; bears S 10°14'12" E, 16.88 ft. (grid).

Note: For further information, contact the Douglas County Surveyor's Office, Room 205 Douglas County Justice Building, Roseburg, OR 97470. Phone 440-4278. Douglas County residents outside the Roseburg calling area, dial toll free 1-800-452-0991.