

OFFICE OF THE
DOUGLAS COUNTY SURVEYOR

Station: COLONIAL T 27 S, R 7 W, Sec 25

Set By (Agency): DCSO

Date Set: 1989

Recovered By RWS, SJF


Date Recovered 5/18/89

Recovered By 12/29/97 RWS, SJF

Date Recovered _____

Recovered By _____

Date Recovered _____

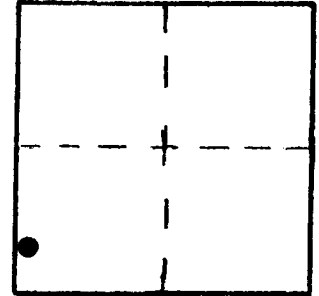

C-139
COLONIAL
27S 7W 25
567699.08 4125159.42
NAD ~~587699.85~~ ~~4125157.25~~
83 ~~48° 5' 11"~~ ~~128° 28' 54"~~

VERTICAL CONTROL NGVD 29 CORPCON 6 NAVD 88 632.084 FT
Elevation: 628.611 NGS Line # _____ USGS Line # _____ OSHD Line # _____
Precision: 2nd Agency: DCSO Proj. # 2007 Date: 1990


HORIZONTAL CONTROL OCS 27
South Zone State Plane Coordinates: Y(Northing) 567,734.28 X(Easting) 1,204,201.03
Precision: 1/25,000 Agency: DCSO Proj. # GPS 27/83 Date: 1991
Approximate Geographic Position: Latitude 43° 11' 08" Longitude 123° 29' 04"

DESCRIPTION and TO REACH

SKETCH

A DCSO disk stamped "COLONIAL 1989" set in an 8 in. dia. by 42 in. long concrete filled belltile protruding 3 in. above ground.

From the intersection of Colonial Rd. (Co.Rd.#52) and Lookingglass Rd. (Co.Rd.#5D) in T27S,R7W, Sec.36, proceed northerly along Colonial Rd. 0.25 miles to monument on right.

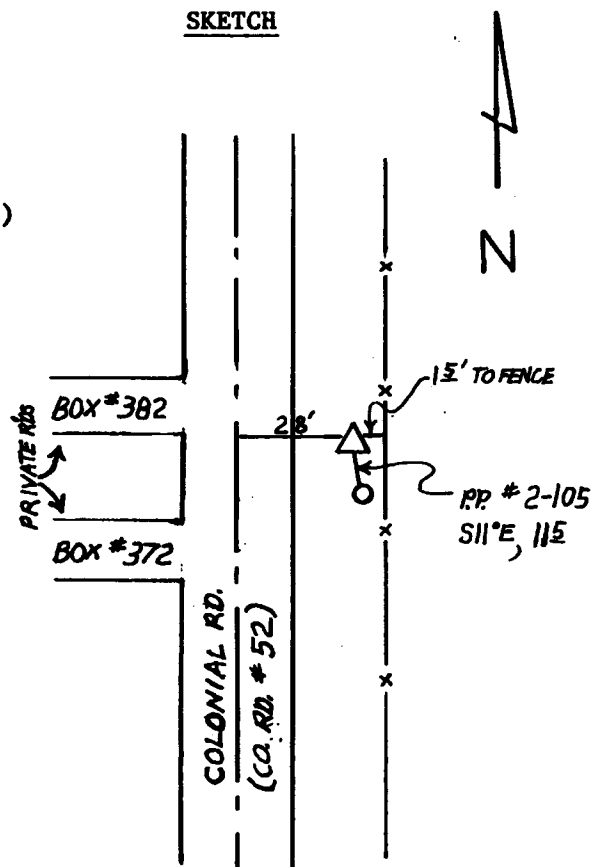

Reference Marks:

Note: For further information, contact the Douglas County Surveyor's Office, Room 205 Douglas County Justice Building, Roseburg, OR 97470. Phone 440-4278. Douglas County residents outside the Roseburg calling area, dial toll free 1-800-452-0991.