

OFFICE OF THE
DOUGLAS COUNTY SURVEYOR

Station: C 741X

T28W R7W Sec. 25

Date Set: 1987

Set By (Agency): NGS

DCSO Designation: C-151

Date Recovered: 8-93



Recovered By: SJF RWS

Date Recovered: _____

Recovered By: _____

Date Recovered: _____

Recovered By: _____

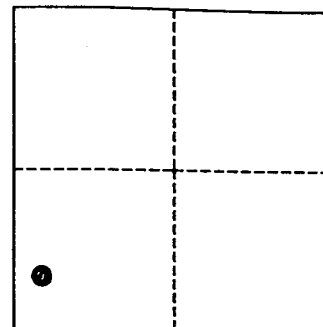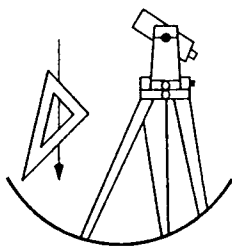

VERTICAL CONTROL

~~NGVD 29~~ Elevation: 764.328 FEET NAVD 88 Elevation: 232.967 METERS

NGS Line # 125034 USGS LINE # _____ OSHD Line # _____ FILE # _____

Precision: 1ST ORDER Agency: NGS Proj: _____ Date: 1988

HORIZONTAL CONTROL

O.C.S. 27 Y(Northing): _____ O.C.S. 83 Y(Northing): 537005

(South Zone) X(Easting): _____ (South Zone) X(Easting): 4124907

Precision: GIS SCALED Agency: DCSO Proj: _____ Date: 2014

Approx. O.C.S. 27 Geographic Position: Latitude: 43°06'04" Longitude: 123°28'53"

Approx. O.C.S. 83 Geographic Position: Latitude: _____ Longitude: _____

Found: A 9/16 inch diameter stainless steel rod under a 6 - 5/8 inch diameter aluminum collar and access cover, set in concrete flush with ground. Collar stamped "C 741X 1987".

To reach: Go to the intersection of State Hwy 42 and Hoover Hill Rd. (Co. Rd. #125) in T28S R7W Sec25 monument is 230 feet southerly of intersection on east side of Hoover Hill Rd.

