



OFFICE OF THE C
DOUGLAS COUNTY SURVEYOR

Station: WY4 S. 2
Date Set: 1978
Set By (Agency): DCSO
Date Recovered: 2-11-97
Recovered By: RLWS STF

T 23 S, R 4W, Sec 2
PLSS 500640

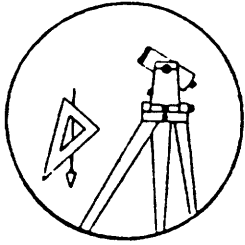

- Found
- Reset
- Referenced
- New
- Not Found
- Destroyed

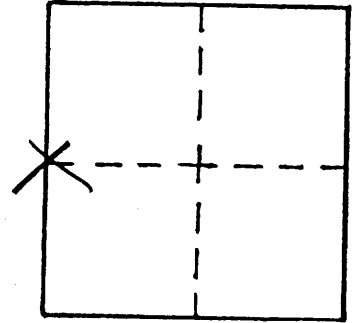

VERTICAL CONTROL

Elevation: 875.04 NGS Line # _____ USGS Line # _____ OSHD Line # _____
Precision: 3rd Agency: DCSO Proj. # 2007 Date: 1997
CS 66/54

HORIZONTAL CONTROL

South Zone O.C.S. 27: Y(Northing) _____ X(Easting) _____
South Zone O.C.S. 83: Y(Northing) 715197 X(Easting) 4220175
Precision: GIS SCALED Agency: DCSO Proj. # _____ Date: 2014
Approx. NAD ⁸³ Geographic Position: Latitude 43°35'55" Longitude 123°08'45"

DESCRIPTION and TO REACH

SEE DCSO CORNER RENEWAL RECORDS

2 1/2" BRASS CAPONA 1 1/2" OP. I.P.
PROTRUDES 2" ABOVE GROUND,

FROM THE INTERSECTION OF SCOTTS VALLEY RD
(CO. RD # 8) AND LONDON HILL RD (CO. RD 8A)
IN T23S R4W SEC. 3 PROCEED SOUTHERLY
ALONG SCOTTS VALLEY RD 0.35 MILES
TO MONUMENT ON LEFT

Reference Marks:

