


write/rain C-155 010

OFFICE OF THE DOUGLAS COUNTY SURVEYOR

C-155

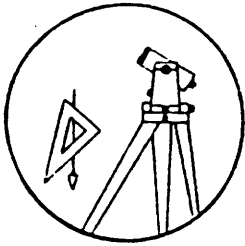

Station: Wc E 1/4 S 32

T 22 S, R 4, Sec 32

Date Set: 1965


PLSS 300140

Set By (Agency): DCSO

Date Recovered: 2/19/97

Recovered By: MWS, SJF

- Found
- New
- Reset
- Not Found
- Referenced
- Destroyed

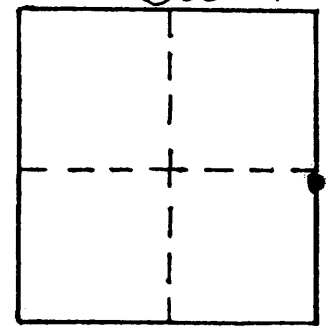

PLSS # 300140

VERTICAL CONTROL

Elevation: 456.32 NGS Line # \_\_\_\_\_ USGS Line # \_\_\_\_\_ OSHD Line # \_\_\_\_\_

Precision: 3rd Agency: DCSO Proj. # C2007 Date: 1997

HORIZONTAL CONTROL

C566/54

South Zone O.C.S. 27: Y(Northing) \_\_\_\_\_ X(Easting) \_\_\_\_\_

South Zone O.C.S. 83: Y(Northing) 720772 X(Easting) 4209789

Precision: GIS SCALED Agency: DCSO Proj. # \_\_\_\_\_ Date: 2014

Approx. 1927 Geographic Position: Latitude 43°36'47" Longitude 123°11'09"

DESCRIPTION and TO REACH

1.95 miles

\_\_\_\_\_  
\_\_\_\_\_  
\_\_\_\_\_

FROM THE INTERSECTION OF ELKHEAD ROAD (Co. Rd. #7) AND SCOTTS VALLEY (Co. Rd. #8) IN T22S R4W SEC 31 PROCEED NORTHERLY AND EASTERLY ALONG SCOTTS VALLEY RD. APPROXIMATELY 1.95 MILES TO MONUMENT ON RIGHT.

\_\_\_\_\_  
\_\_\_\_\_  
\_\_\_\_\_

Reference Marks:

\_\_\_\_\_  
\_\_\_\_\_  
\_\_\_\_\_  
\_\_\_\_\_

