


OFFICE OF THE
DOUGLAS COUNTY SURVEYOR

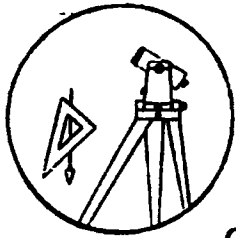

C-169

Station: CALKINS

T 22 S, R 6W, Sec 15


Date Set: 2000

Set By (Agency): DCSO

Date Recovered: 3-30-00

Recovered By: RUS, SJF

- Found
- New
- Reset
- Not Found
- Referenced
- Destroyed

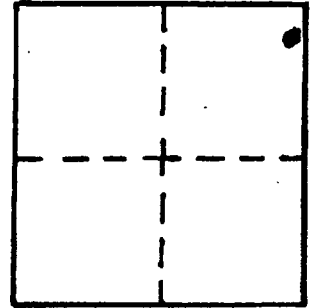

VERTICAL CONTROL NGVD 29 CORPSCON 6 NAVD 88 464.86 FT

Elevation: 461.40 NGS Line # _____ USGS Line # _____ OSHD Line # _____

Precision: 3rd Agency: DCSO Proj. # CS 66/38 Date: 2000

HORIZONTAL CONTROL

South Zone O.C.S. 27: Y(Northing) _____ X(Easting) _____

South Zone O.C.S. 83: Y(Northing) _____ X(Easting) _____

Precision: _____ Agency: _____ Proj. # _____ Date: _____

Approx. NAD 83 Geographic Position: Latitude 43° 13' 39.9" Longitude 123° 23' 13.0"
27 43° 13' 40.5" 123° 23' 08.8"

DESCRIPTION and TO REACH

SET DCSO DRILL CAP IN TOP OF A CONCRETE
RETAINING WALL STAMPED "CALKINS 2000"

GO TO THE INTERSECTION OF CALKINS AVE AND
TRUST ST. IN ROSEBURG. MONUMENT IS AT THE
NORTH WEST CORNER OF INTERSECTION.

Reference Marks:

