

OFFICE OF THE  
DOUGLAS COUNTY SURVEYOR

Station: DAIRY T 27 S, R 6 W, Sec 24

Set By (Agency): ?

Date Set: ?

Recovered By LEM, TP


Date Recovered 9/81

Recovered By RWS-SJP 2000

Date Recovered \_\_\_\_\_

Recovered By \_\_\_\_\_

Date Recovered \_\_\_\_\_

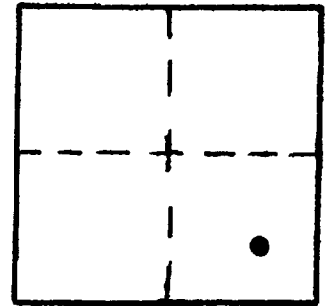

d-015  
DAIRY

27S 6W 24

NAD 573147.90 4160906.25  
83 43°12'14" 123°21' 9"

VERTICAL CONTROL NGVD 29 CORPSCONG NAVD 88 487.08 FT

Elevation: 483.61 NGS Line # \_\_\_\_\_ USGS Line # \_\_\_\_\_ OSHD Line # \_\_\_\_\_

Precision: 3m Agency: DCSO Proj. # 66/38 Date: 2000

HORIZONTAL CONTROL OCS 27

South Zone State Plane Coordinates: Y(Northing) 573,183.10 X(Easting) 1,239,947.90

Precision: 1/20,000 Agency: DCSO Proj. # 2005-2 Date: 1983

Approximate Geographic Position: Latitude 43°12' 14.2" Longitude 123°21' 04.7"

DESCRIPTION and TO REACH


SKETCH

DESCRIPTION:

A 3 in. diam. brass cap stamped "DAIRY 1981"  
set in concrete monument with metal collar.

TO REACH:

Go to intersection of SE Sykes Ave. and  
SE Mill St.

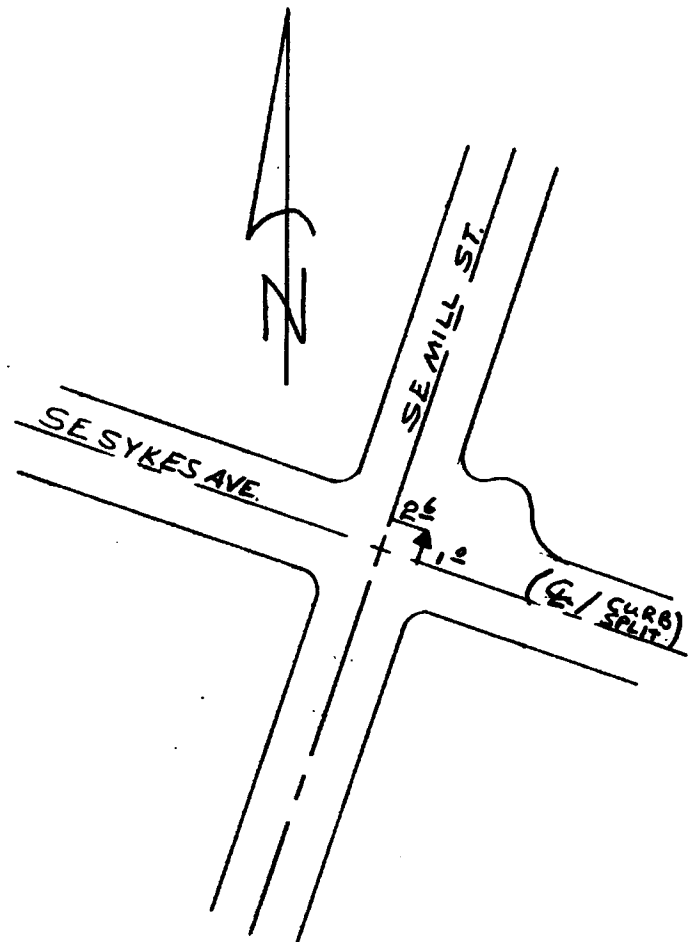

Reference Marks:

Note: For further information, contact the Douglas County Surveyor's Office, Room 205 Douglas County Justice Building, Roseburg, OR 97470. Phone 440-4278. Douglas County residents outside the Roseburg calling area, dial toll free 1-800-452-0991.