

OFFICE OF THE
DOUGLAS COUNTY SURVEYOR

Station: DIXIE T 27 S, R 5 W, Sec 24

Set By (Agency): DCSO

Date Set: 1980

Recovered By RWS, SJF


Date Recovered 1/87 & 2/03

Recovered By _____

Date Recovered _____

Recovered By _____

Date Recovered _____

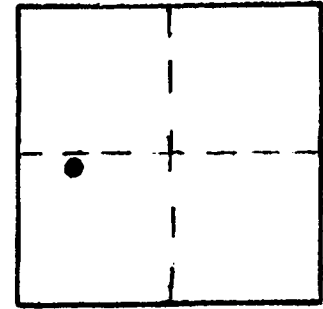

d-047
DIXIE

27S 5W 24

NAD 83 573282.62 4190390.50
43°12'25" 123°14'31"

VERTICAL CONTROL

Elevation: 572.41 577.41 CORPSCON 6 NAVD 88 580.91 FT
NGS Line # _____ USGS Line # _____ OSHD Line # _____

Precision: 3RD Agency: DCSO Proj. # 2007 Date: 2003
CS 66/63

HORIZONTAL CONTROL OCS 27

South Zone State Plane Coordinates: Y(Northing) 573,318.05 X(Easting) 1 269,432.05

Precision: 1/25 000 Agency: DCSO Proj. # 2004-19 Date: 1980

Approximate Geographic Position: Latitude 43°12'25" Longitude 123°14'27"


DESCRIPTION and TO REACH

A DCSO disk stamped "DIXIE 1980" set in an 8 inch od. concrete filled belltile flush with ground.

TO REACH:

Go to the intersection of Co. Rd. #16 (Dixonville, Roberts Creek, Carnes Rd.) and Co. Rd. #17 (Little River, Buckhorn Rd.) in T27S, R5W, Sec. 24, monument is in southwest corner of intersection.

SKETCH

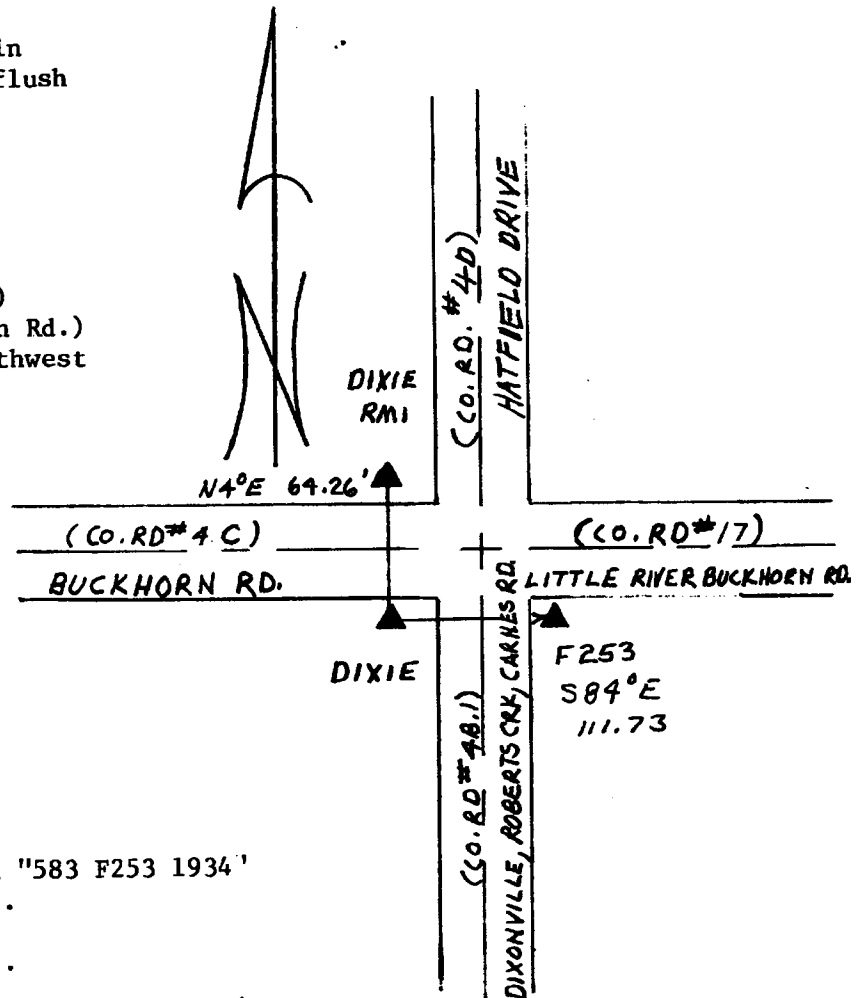

Reference Marks:

- A DCSO disk stamped "DIXIE RMI 1980" bears N 5°55'50" E, 64.26 ft. (grid).
- An Oregon Geodetic Survey disk stamped "583 F253 1934" bears S 82°24'13" E, 111.73 ft. (grid).
- A DCSO disk stamped "DIXIE AZI 1980" bears N 84°43'14" W, 956.48 ft. (grid).

Note: For further information, contact the Douglas County Surveyor's Office, Room 205 Douglas County Justice Building, Roseburg, OR 97470. Phone 440-4278. Douglas County residents outside the Roseburg calling area, dial toll free 1-800-452-0991.