

OFFICE OF THE
DOUGLAS COUNTY SURVEYOR

Station: D 502 T30 S, R 2E , Sec 33

Set By (Agency): USC & GS

Date Set: 1949

Recovered By DCSO


Date Recovered 8-27-86

Recovered By _____


Date Recovered _____

Recovered By _____

Date Recovered _____

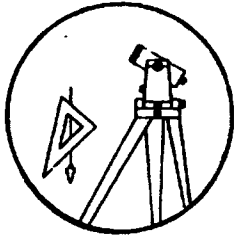

D-067

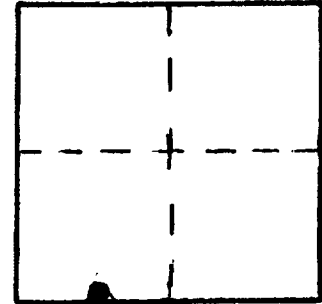

VERTICAL CONTROL NGVD 29 CORPSCON NAVD 88 5651.846 FT

Elevation: 5648.299 NGS Line # 130 USGS Line # _____ OSHD Line # _____

Precision: 2nd Agency: USC&GS Proj. # 2013 Date: 1957

HORIZONTAL CONTROL

South Zone State Plane Coordinates: Y(Northing) _____ X(Easting) _____

Precision: _____ Agency: _____ Proj. # _____ Date: _____

Approximate Geographic Position: Latitude _____ Longitude _____

DESCRIPTION and TO REACH

SKETCH

0.8 miles Southwesterly along old road on top of divide from intersection of roads 68, 30, and 800, in T30S, R2E, Sec. 33, 25 feet west of road at top of knob.

Brass Cap in round concrete monument, 0.3 feet above ground with witness post.

Reference Marks:

Note: For further information, contact the Douglas County Surveyor's Office, Room 205 Douglas County Justice Building, Roseburg, OR 97470. Phone 440-4278. Douglas County residents outside the Roseburg calling area, dial toll free 1-800-452-0991.