

Douglas County Geodetic Data Sheet


T 29 R 06 WS 04 A

Station: DILL-3

Designation: D-088

Date Set: 1998 Set By (Agency): DCSO

Last Date Recovered: 01/00/2001

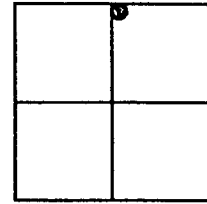

VERTICAL CONTROL

NGVD 29 Elevation: 537.97 Feet

Precision: 3RD ORDER Agency: DCSO

CS File: 66055

Date: 1998

NAVD 88 Elevation: 541.43 FT.

Precision: CORPSCON6 Agency:

CS File:

Date:

NAVD88

HORIZONTAL CONTROL

OCS 27 Y(Northing):

X(Easting):

Lat 43° 05' 01.0"

Long: 123° 24' 47.7"

Precision: GIS Agency:

CS File:

Date:

OCS 83 Y(Northing): 529923 X(Easting): 4142865

Lat

Long:

Precision: GISSCALED Agency: DCSO

CS File:

Date: 2014

OCS 83/91 Y(Northing):

X(Easting):

Lat

Long:

Precision: Agency:

CS File:

Date:

OCS 83/98 Y(Northing):

X(Easting):

Lat

Long:

Precision: Agency:

CS File:

Date:

Description:

Scaled Lat 43° 05' 01"


Long: 123° 24' 48"

A DCSO BRASS CAP STAMPED; DILL-3 1998; SET IN NORTHEAST CONCRETE BRIDGE ABUTMENT.

Comments:

FROM THE INTERSECTION OF WILLIS CREEK RD;
CO. RD 43; AND BROCKWAY ROAD; CO. RD 47F;
IN T28S R6W SEC.32; PROCEED
SOUTHEASTERLY ALONG WILLIS CREEK RD 1.45
MILES TO BRIDGE OVER RICE CREEK AND
MONUMENT ON LEFT.

Notes:

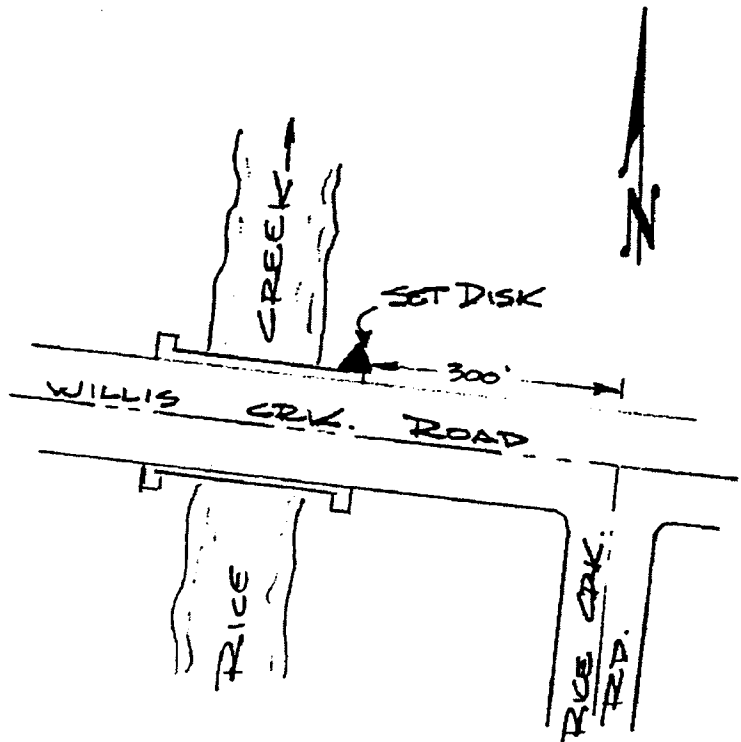

Note: For further information contact the Douglas County Surveyors Office, Room 105A Douglas County Courthouse, Roseburg, OR 97470. Phone 440-4272 or Fax (541)957-8150. Douglas County Residents outside Roseburg calling area, dial toll free 1-800-224-1619.