



OFFICE OF THE
DOUGLAS COUNTY SURVEYOR

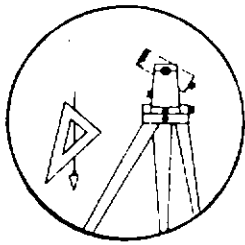

Station: E335 T 25 S, R 6 W, Sec 3
Set By (Agency): USC&GS
Date Set: 1934
Recovered By PWS, SJF
Date Recovered 3/30/87
Recovered By _____
Date Recovered _____
Recovered By _____
Date Recovered _____

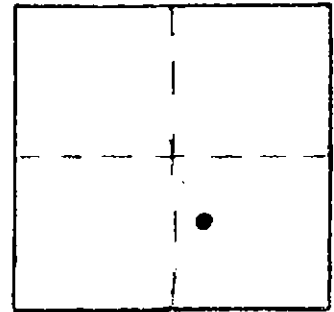

VERTICAL CONTROL

Elevation: 464.11 NGS Line # _____ USGS Line # _____ OSHD Line # 326
Precision: 3rd Agency: OSHD Proj. # _____ Date: 1963


HORIZONTAL CONTROL

South Zone State Plane Coordinates: Y(Northing) _____ X(Easting) _____
Precision: _____ Agency: _____ Proj. # _____ Date: _____
Approximate Geographic Position: Latitude _____ Longitude _____

DESCRIPTION and TO REACH

A USC&GS disk stamped "E335 464 1934"
set in a 10 in. square concrete post
flush with ground.

SKETCH

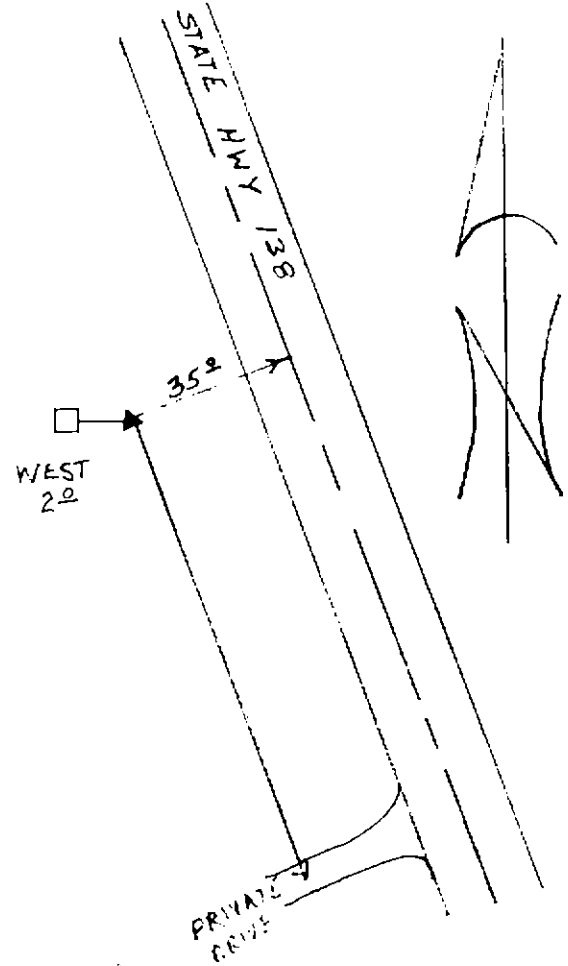

TO REACH:

From the intersection of State Hwy. #138
and Rolling Ridge Rd. (Co. Rd. #10) in
T25S, R6W, Sec. 11, proceed northwesterly
along State Hwy. #138, 1.3 miles to monument:
on left.

Reference Marks:

Note: For further information, contact the Douglas County Surveyor's Office, Room 205
Douglas County Justice Building, Roseburg, OR 97470. Phone 440-4278. Douglas
County residents outside the Roseburg calling area, dial toll free 1-800-452-0991.