

OFFICE OF THE
DOUGLAS COUNTY SURVEYOR

Station: EVELYN T 27 S, R 6 W, Sec 6

Set By (Agency): ?

Date Set: ?

Recovered By RWS, SJF



Date Recovered 5/19/89

Recovered By _____

Date Recovered _____

Recovered By _____

Date Recovered _____

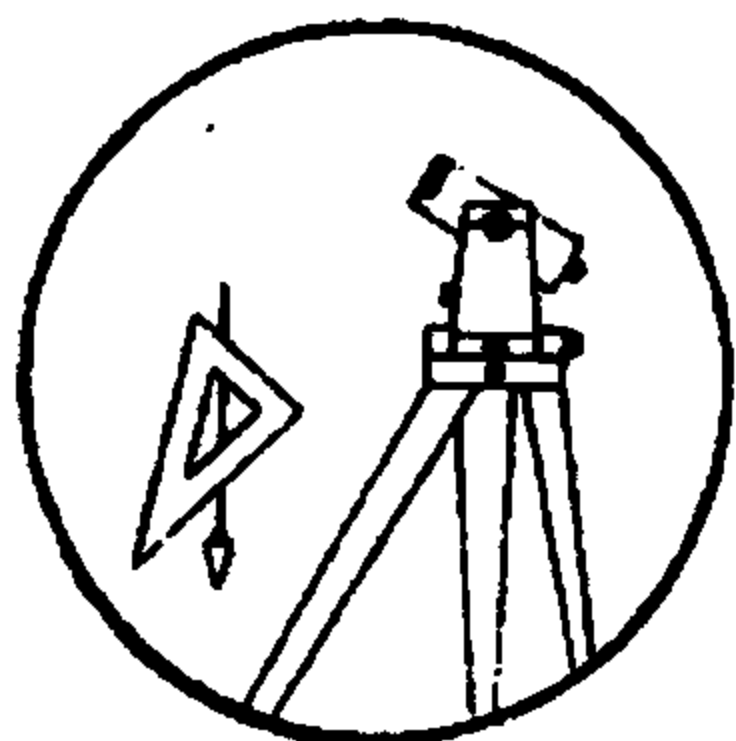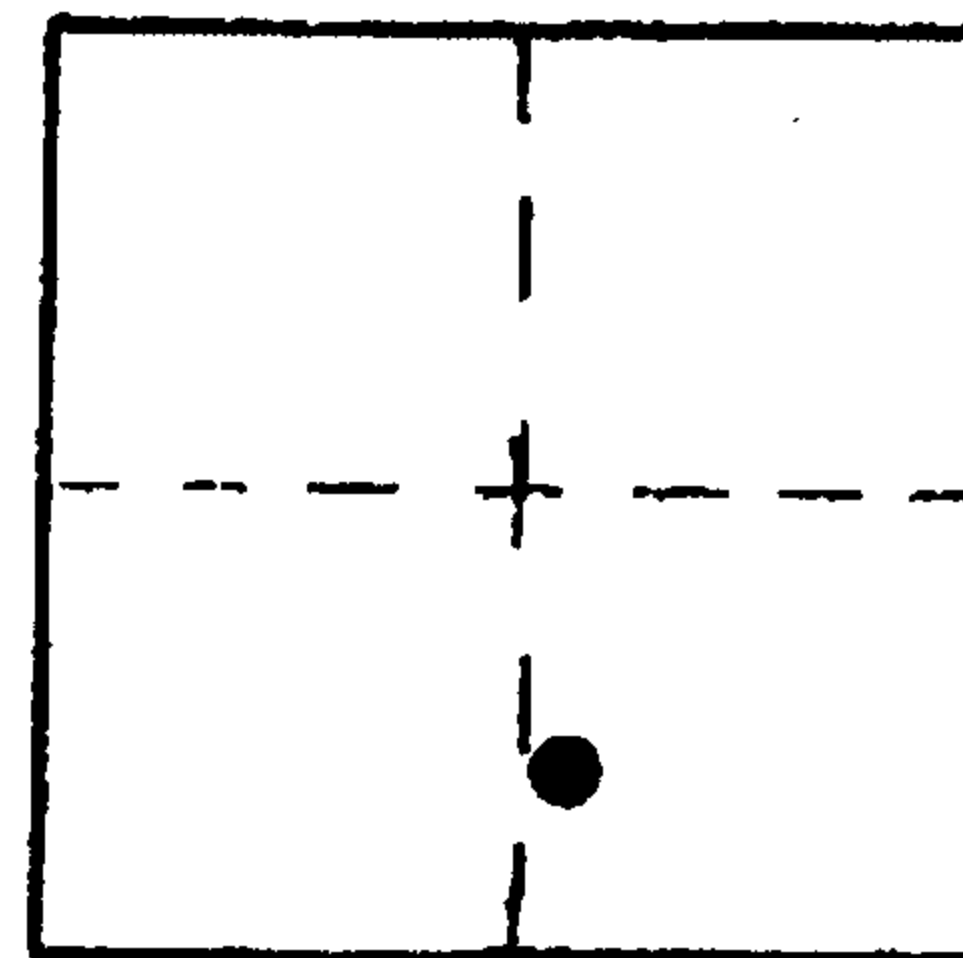

E-031

VERTICAL CONTROL **NGVD 29 CORPCON 6 NAVD 88 406.131 FT**

Elevation: 402.683 NGS Line # _____ USGS Line # _____ OSHD Line # _____

Precision: 2nd Agency: DCSO Proj. # 2007 Date: 1990

HORIZONTAL CONTROL

South Zone State Plane Coordinates: Y(Northing) _____ X(Easting) _____

Precision: _____ Agency: _____ Proj. # _____ Date: _____


Approximate Geographic Position: Latitude _____ Longitude _____

DESCRIPTION and TO REACH

SKETCH

A 2 1/2 in. disk stamped "DCSO EVELYN 1989" set flush in concrete wingwall of bridge over champagne creek.

From the intersection of Melqua road (Co.Rd.#13A) and Melrose Rd. (Co.Rd.#13) in T27S,R6W,Sec.6, proceed easterly along Melrose Rd. approx. 0.2 miles to monument on left.

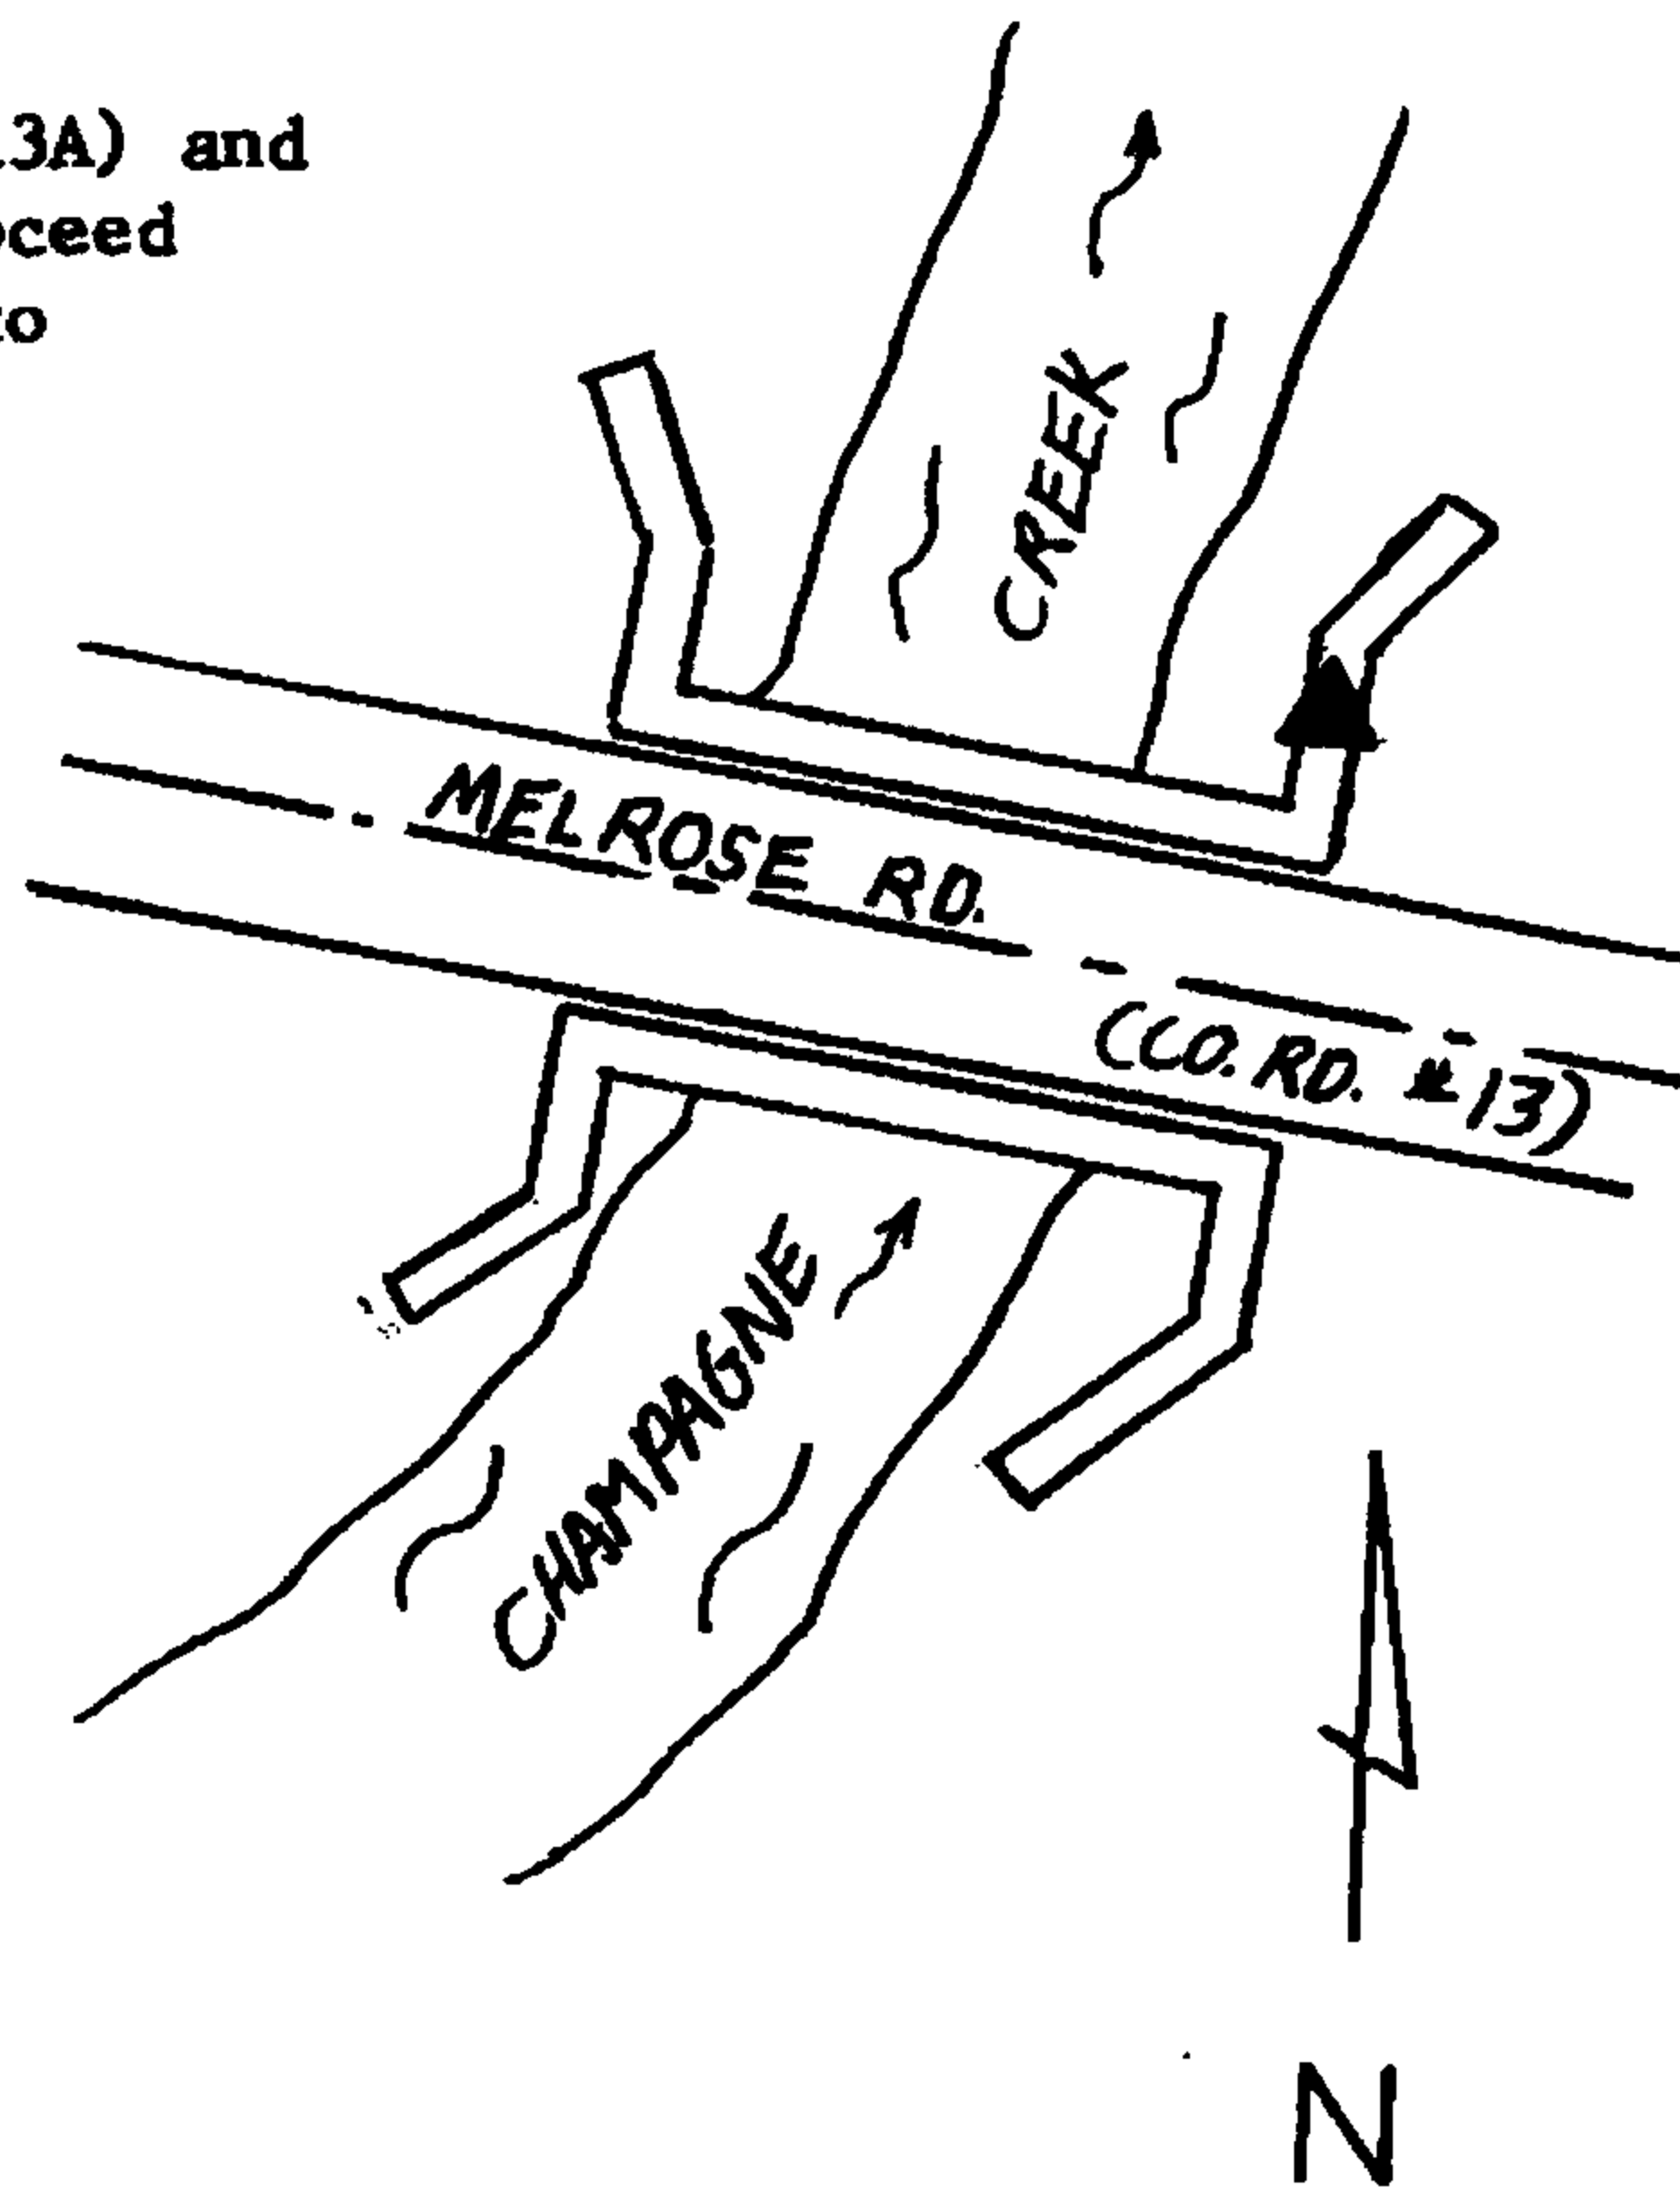

Reference Marks:

Note: For further information, contact the Douglas County Surveyor's Office, Room 205 Douglas County Justice Building, Roseburg, OR 97470. Phone 440-4278. Douglas County residents outside the Roseburg calling area, dial toll free 1-800-452-0991.