

OFFICE OF THE DOUGLAS COUNTY SURVEYOR

Station: EMU


T 23 S, R 4W, Sec 28

Date Set: 2/26/97


Set By (Agency): DCSO

Date Recovered: 2/26/97

Recovered By: RWS, SJF

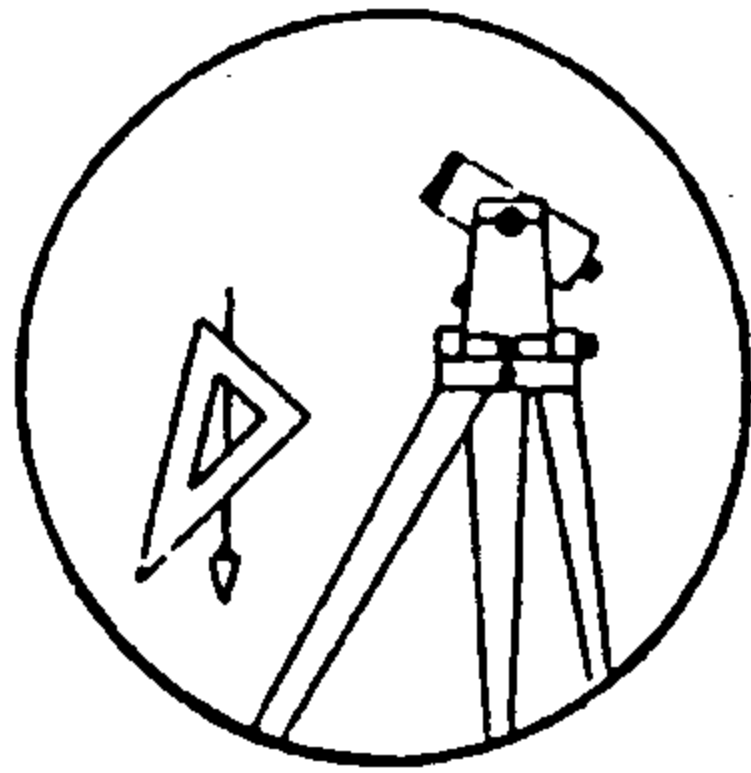

- Found
- New
- Reset
- Not Found
- Referenced
- Destroyed

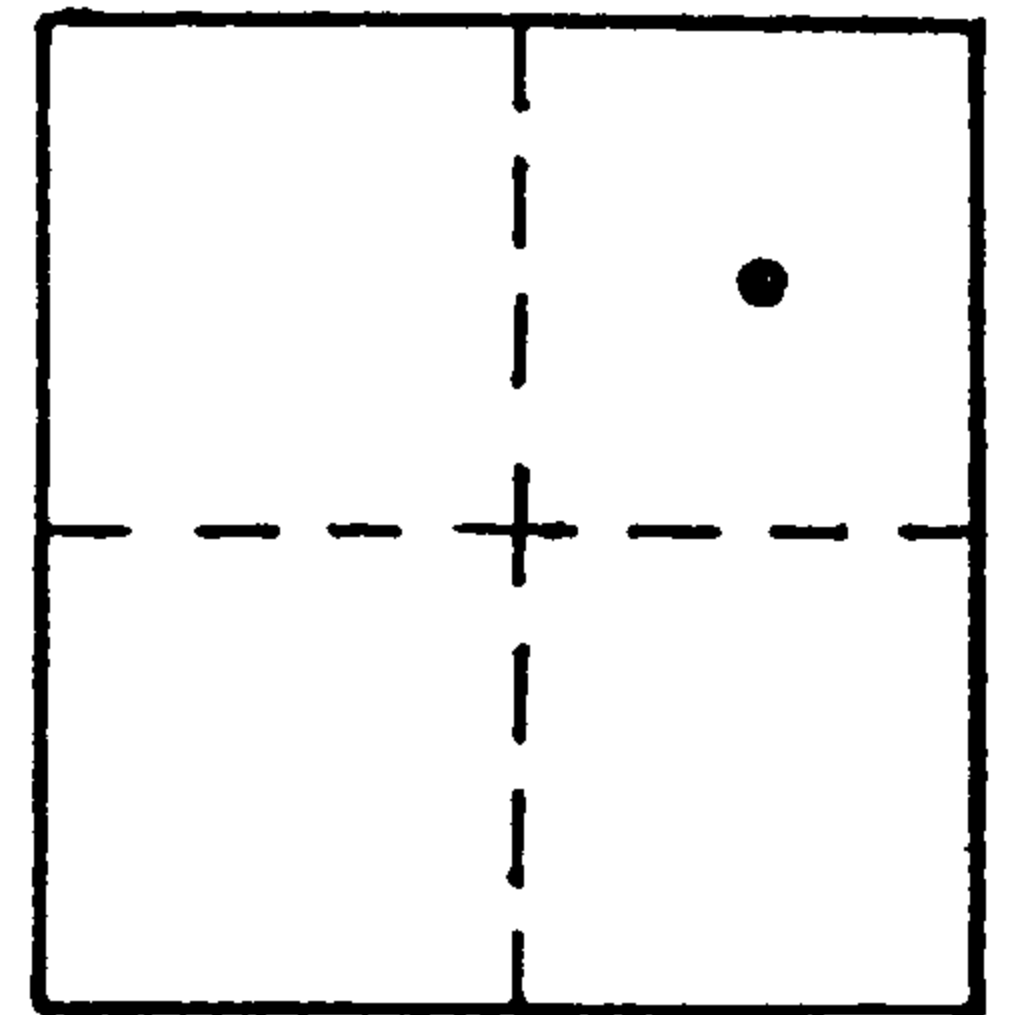

VERTICAL CONTROL

Elevation: 752.31 NGS Line # _____ USGS Line # _____ OSHD Line # _____

Precision: 3rd Agency: DCSO Proj. # 2007 Date: 1997

HORIZONTAL CONTROL CORPSCON6 NAVDBB 756.00 FT. CS 66154

South Zone O.C.S. 27: Y(Northing) _____ X(Easting) _____

South Zone O.C.S. 83: Y(Northing) 695794 X(Easting) 4212959

Precision: GIS SCALED Agency: DCSO Proj. # _____ Date: 2014

Approx. Geographic Position: Latitude 43°32'42" Longitude 123°10'15"

DESCRIPTION and TO REACH

A 3 INCH DIAMETER DCSO DISK STAMPED "EMU 1997" SET FLUSH IN TOP OF 8 INCH I.D. X 40 INCH LONG CONCRETE FILLED PLASTIC PIPE SET PROTRUDING APPROXIMATELY 2 INCHES ABOVE GROUND.

FROM THE INTERSECTION OF SCOTTS VALLEY RD (Co. Rd. #8) AND ROMIE HOWARD RD. (Co. Rd. #69) IN T23S R4W SECTION 21 PROCEED SOUTHERLY ALONG ROMIE HOWARD RD. APPROXIMATELY 0.5 MILES TO MONUMENT ON RIGHT.

Reference Marks:

