

Douglas County Geodetic Data Sheet


T 29 R 06 WS 15 D

Station: EWC-2

Designation: E-041

Date Set: 1998 Set By (Agency): DCSO

Last Date Recovered: 12/00/2000

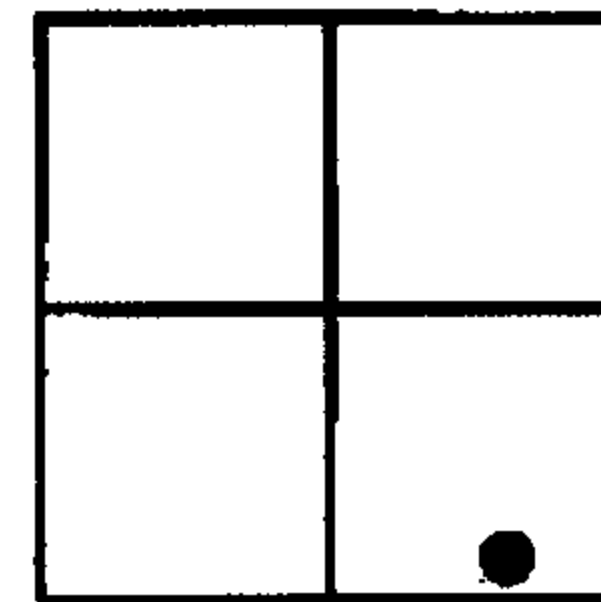

VERTICAL CONTROL

NGVD 29 Elevation: 719.06 Feet

Precision: 3RD ORDER Agency: DCSO
 CORPCON 6 NAVD 88 722.52 FT.
 NAVD 88 Elevation: ~~719.06~~

CS File: 86055

Date: 1998

Precision: Agency:

CS File:

Date:

HORIZONTAL CONTROL

OCS 27 Y(Northing): X(Easting):
 Precision: GIS Agency: DCSO

Lat 43° 02' 31.5" Long: 123° 23' 18.9"

CS File: 66055 Date: 2000

OCS 83 Y(Northing): X(Easting):
 Precision: Agency:

Lat Long:

CS File: Date:

OCS 83/91 Y(Northing): X(Easting):
 Precision: Agency:

Lat Long:

CS File: Date:

OCS 83/98 Y(Northing): X(Easting):
 Precision: Agency:

Lat Long:

CS File: Date:

Description:


Scaled Lat 43° 02' 32" Long: 123° 23' 19"

A DCSO DRILL CAP STAMPED; EWC-2 1998; SET FLUSH IN TOP OF 8 X 42 INCH CONCRETE FILLED BELL TILE THAT PROTRUDES 7 INCHES ABOVE GROUND.

Comments:

FROM THE INTERSECTION OF WILLIS CREEK RD;
 CO. RD 88; AND EAST WILLIS CREEK RD; CO. RD
 88B; IN T29S R6W SEC. 15; PROCEED
 SOUTHERLY ALONG EAST WILLIS CREEK RD
 APPROX. 1.0 MILE TO TURN-AROUND AT END OF
 COUNTY MAINTAINED ROAD.

Notes:

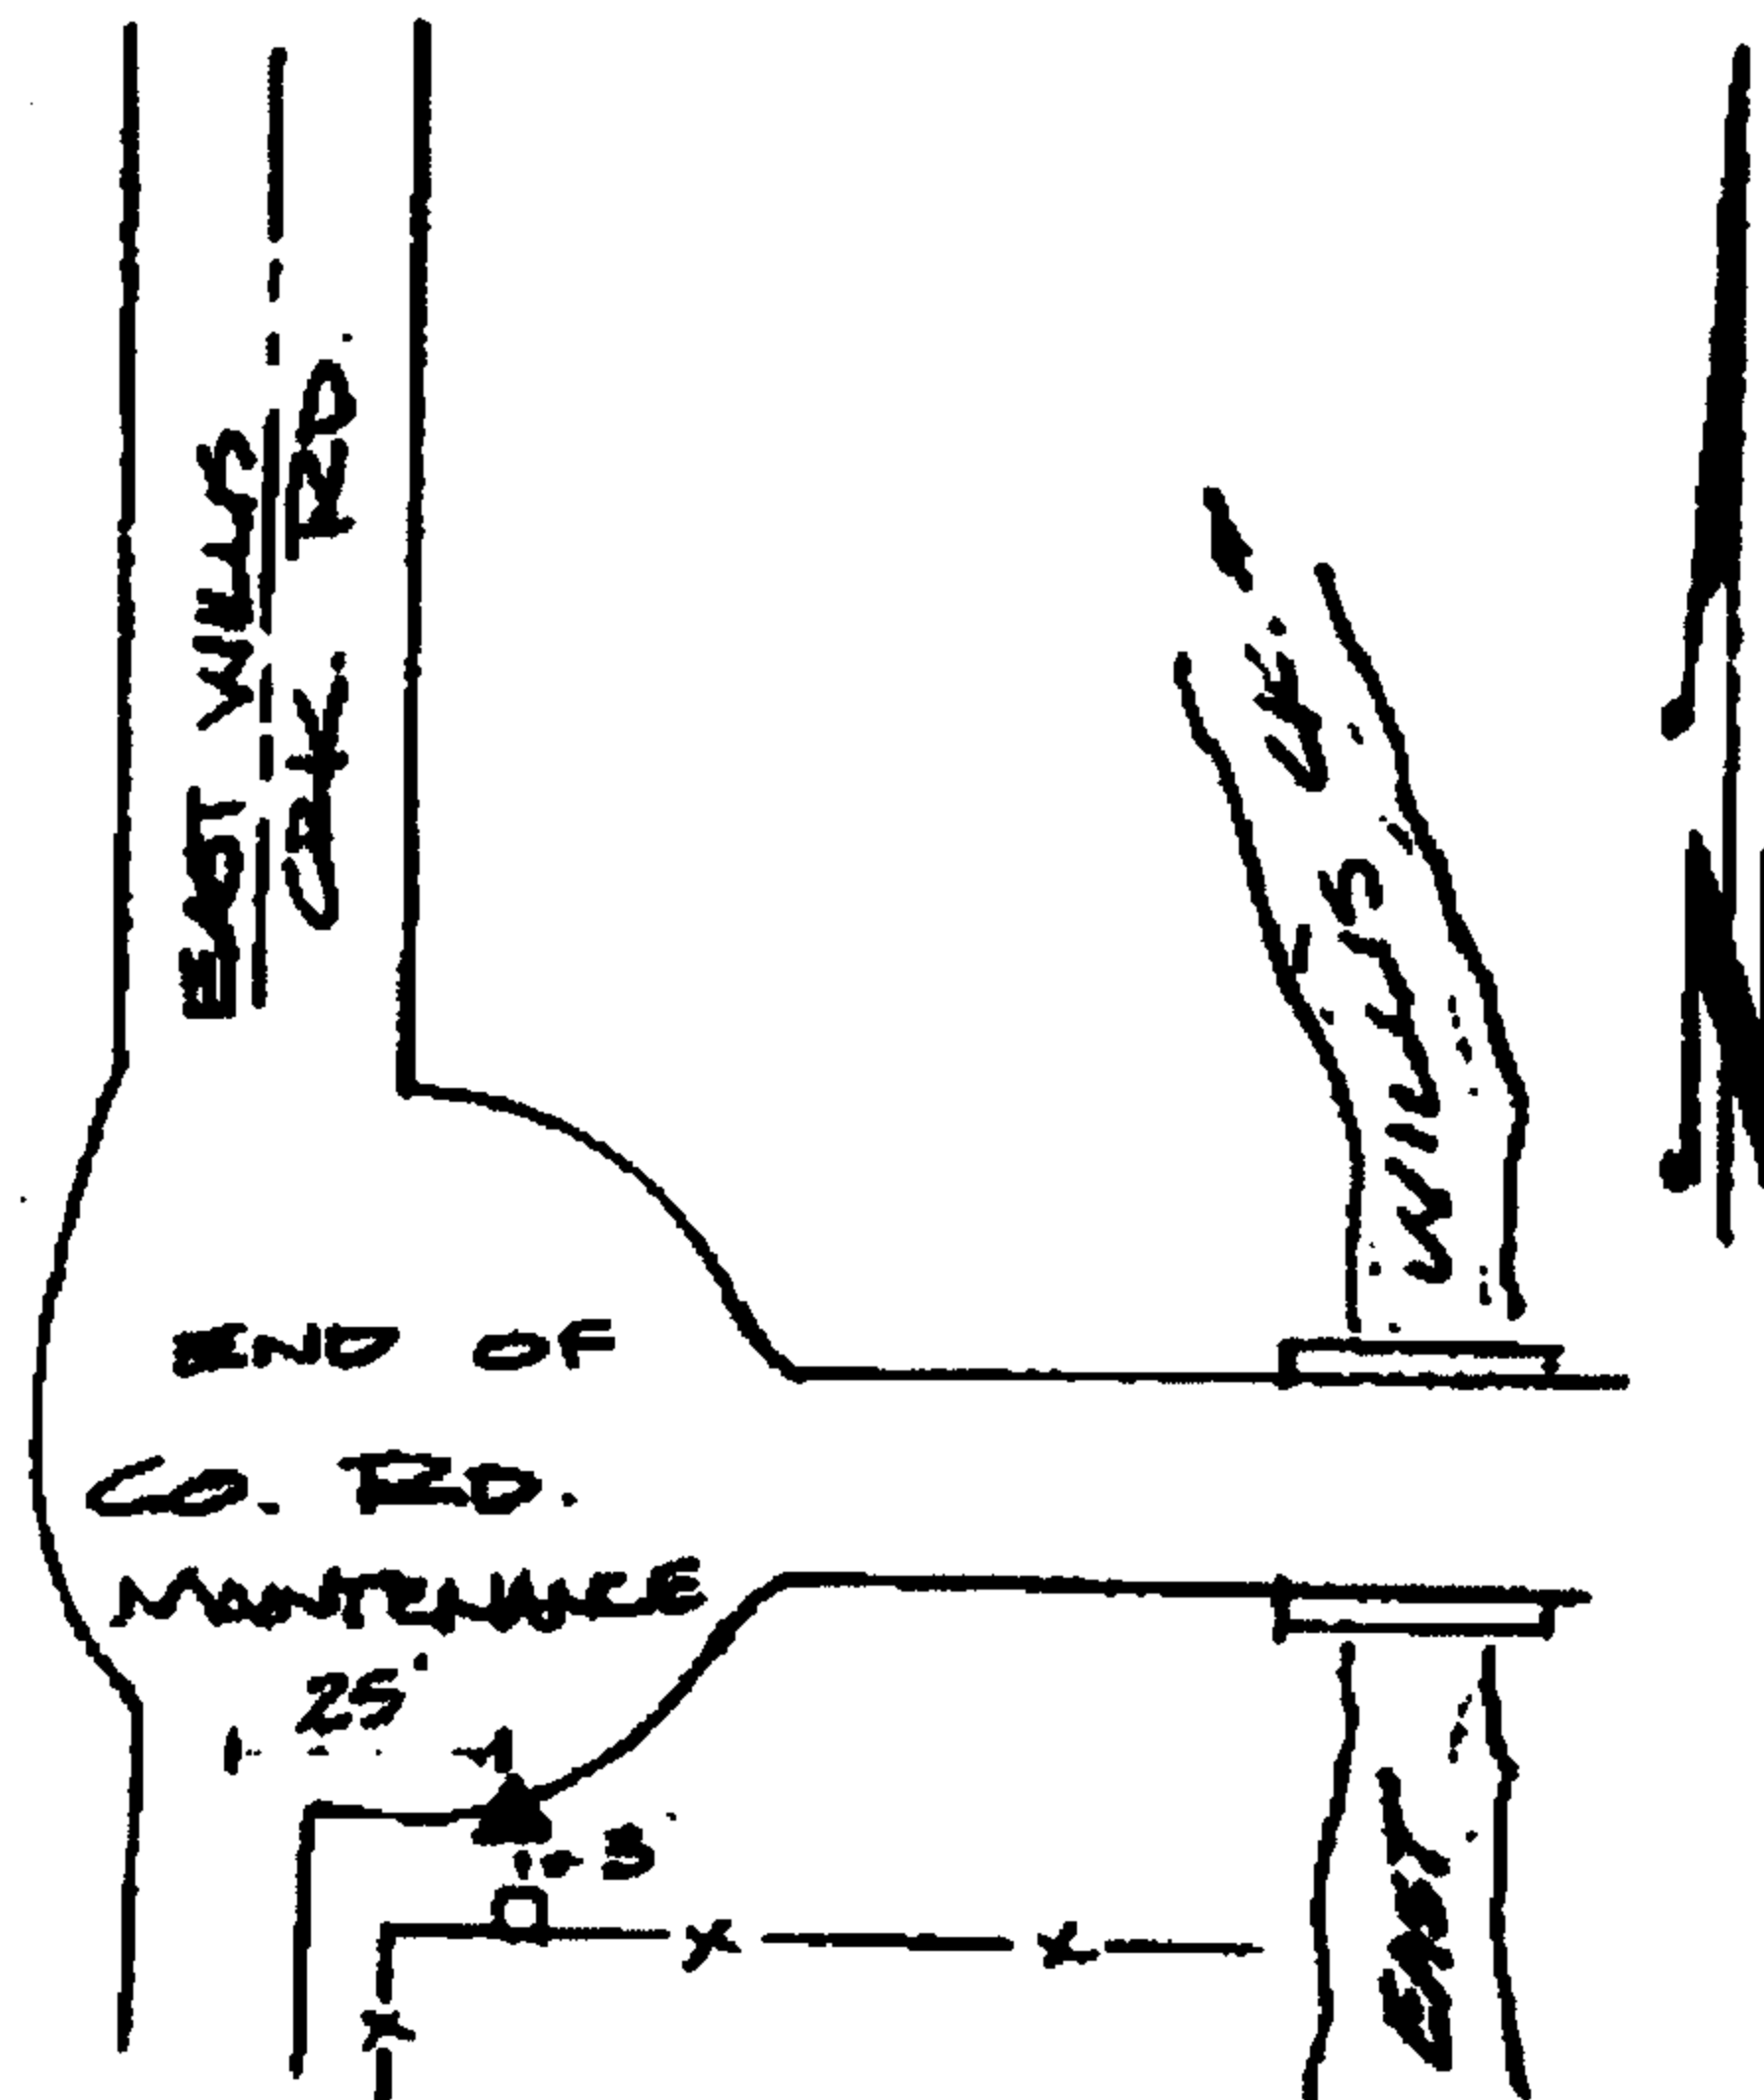

Note: For further information contact the Douglas County Surveyors Office, Room 105A Douglas County Courthouse, Roseburg, OR 97470. Phone 440-4272 or Fax (541)957-8150. Douglas County Residents outside Roseburg calling area, dial toll free 1-800-224-1619.