

write/rain

OFFICE OF THE  
DOUGLAS COUNTY SURVEYOR

Station: ESTHER

T 30 S, R 5W, Sec 7



Date Set: 2001

Set By (Agency): DCSO

Date Recovered: 1-19-01

Recovered By: RWS SJF  
SJF-MK 2-6-2012

- Found
- New
- Reset
- Not Found
- Referenced
- Destroyed

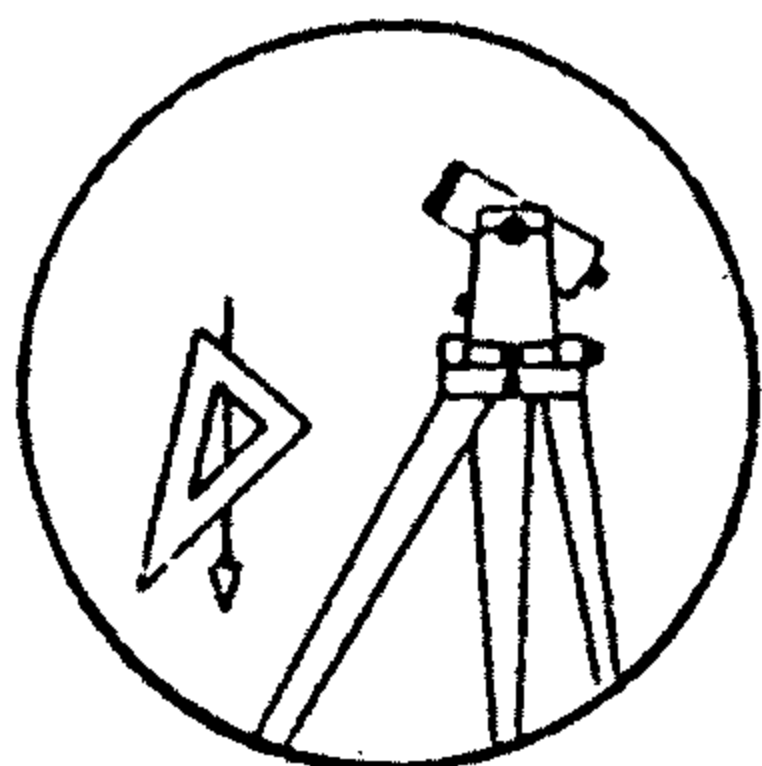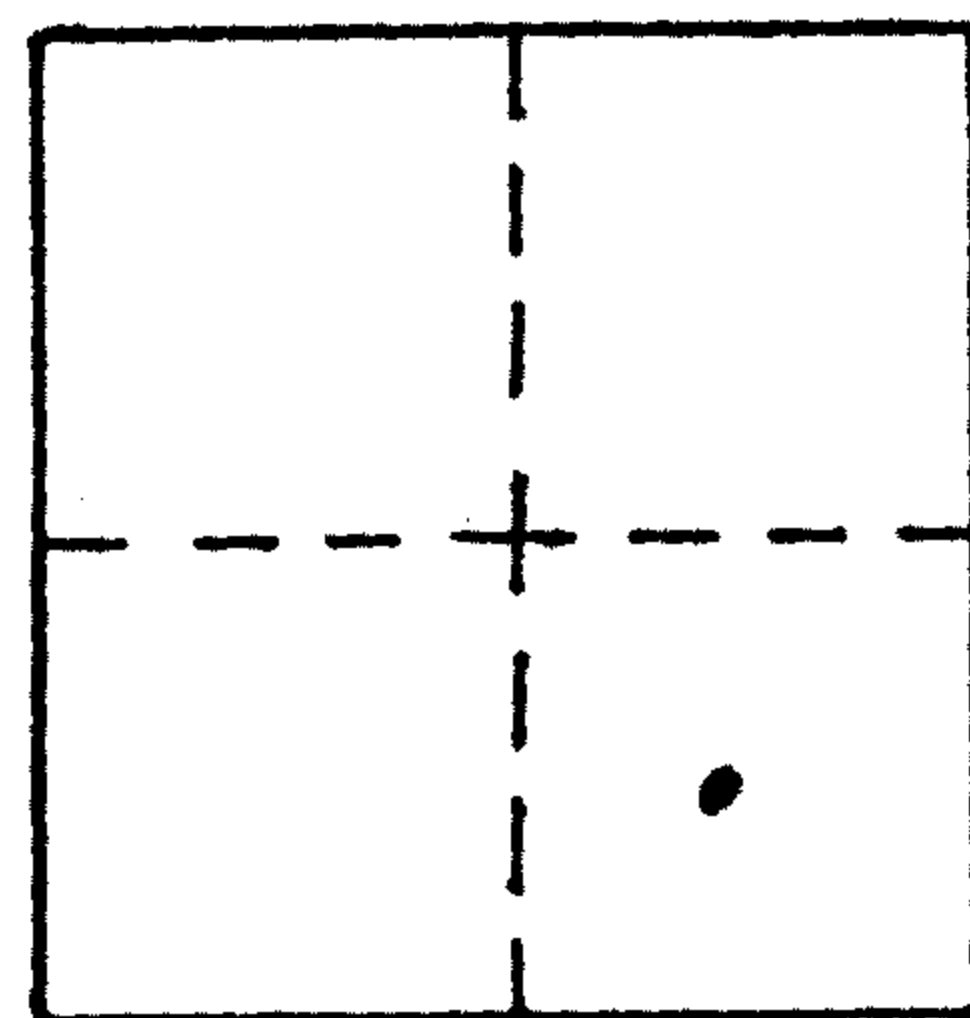

E-045

VERTICAL CONTROL NGVD 29

CORPSCON6 NAVD88 697.33 FT.

Elevation: 693.92 NGS Line # \_\_\_\_\_ USGS Line # \_\_\_\_\_ OSHD Line # \_\_\_\_\_

Precision: 3rd Agency: DCSO Proj. # 66190 Date: 2001

HORIZONTAL CONTROL

South Zone O.C.S. 27: Y(Northing) \_\_\_\_\_ X(Easting) \_\_\_\_\_

South Zone O.C.S. 83: Y(Northing) 488852 X(Easting) 4164093

Precision: GLSCALED Agency: DCSO Proj. # \_\_\_\_\_ Date: 2014

Approx. NAD 83 Geographic Position: Latitude 42° 58' 22" Longitude 123° 19' 44"

DESCRIPTION and TO REACH

DCSO DRILL CAP SET 3'x4' CONCRETE MAIL BOX'S  
PAD STAMPED "ESTHER 2001"

FROM THE INTERSECTION OF OLD HWY 99 (CO RD 386)  
AND BILLS RD (CO RD 248) PROCEED SOUTHERLY ALONG  
BILLS RD APPROX 150 FT TO MONUMENT ON RIGHT  
IN TRI CITY.

Reference Marks:

