


DOUGLAS COUNTY SURVEYOR'S OFFICE

Designation: E-047 Station: ELKTON T 225 R 07W S 19 ¼ D

Date Set: OCTOBER, 2008 Set by (Agency): DCSO

Date Recovered: 11/12/08 Recovered by: SJF, JAP

- Found
- New
- Reset
- Not Found
- Referenced
- Destroyed

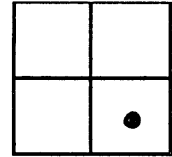

VERTICAL CONTROL

NGVD 29 Elevation: 113.66 Feet File # _____
 Precision: 3RD ORDER Agency: DCSO Project: 2006 Date: 11/19/08
 NAVD 88 Elevation: _____ Meters File # _____
 Precision: _____ Agency: _____ Project: _____ Date: _____

HORIZONTAL CONTROL - south-zone

N _____	E _____	Datum/Adj.: _____	Precision: _____
Lat: _____	Long: _____	Agency: _____	File # _____ Date: _____
N _____	E _____	Datum/Adj.: _____	Precision: _____
Lat: _____	Long: _____	Agency: _____	File # _____ Date: _____
N _____	E _____	Datum/Adj.: _____	Precision: _____
Lat: _____	Long: _____	Agency: _____	File # _____ Date: _____
N _____	E _____	Datum/Adj.: _____	Precision: _____
Lat: _____	Long: _____	Agency: _____	File # _____ Date: _____

DESCRIPTION AND TO REACH

A 3 INCH DIAM. DCSO DRILL CAP STAMPED "ELKTON 2008" SET IN SOUTH END OF CONCRETE SIDEWALK AGAINST THE EASTERLY WALL OF THE OLDEST BUILDING ON THE ELKTON HIGH-SCHOOL CAMPUS.

FROM THE INTERSECTION OF STATE HIGHWAY 38 AND RIVER DRIVE (Co. Rd. # 2E) IN T225, R07W, SECTION 19 PROCEED EAST-SOUTHEASTERLY ALONG RIVER DRIVE APPROX. 0.4 MILES TO MONUMENT ON LEFT.

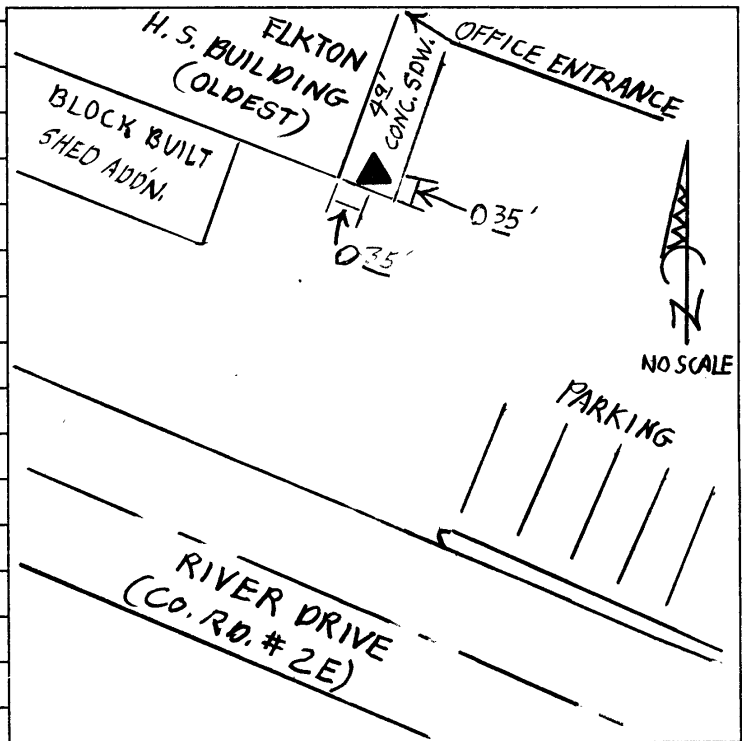


PHOTO FILE NAME

LOCATION

100-1360 (7/22/09 renamed)
to E-047

M-121013A

PROCESSED BY: _____

DATE: _____



12.10.2008