


OFFICE OF THE
DOUGLAS COUNTY SURVEYOR

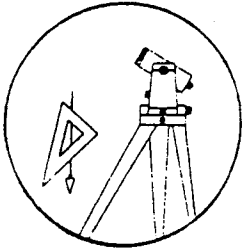

DES. F-037

VERTICAL CONTROL

Elevation: 766.238 NGS Line # _____ USGS Line # _____ OSHD Line # _____

Precision: 2nd Agency: DCSO Proj. # 2007 Date: 1990

HORIZONTAL CONTROL CORPSCON6 NAVD88 769.632 FT CS66/43

South Zone O.C.S. 27: Y(Northing) _____ X(Easting) _____

South Zone O.C.S. 83: Y(Northing) 517272 X(Easting) 4197206

Precision: GIS SCALED Agency: DCSO Proj. # _____ Date: 2014

Approx. NAD ~~83~~ Geographic Position: Latitude 43°03'15" Longitude 123°12'31"

DESCRIPTION and TO REACH

A standard DCSO disk stamped "FUD 1990" set in a 8" x 40" concrete filled belltile protruding 3" above ground.

To reach:

From the intersection of North Myrtle Rd. (Co. Rd. #15) and Bilger Creek Rd. (Co. Rd. #103) in T29S, R5W, sec. 14 proceed northeasterly along North Myrtle Rd. 2.75 mi. to mon. on the left.

Station: FUD

T 29 S, R 4W , Sec 18

Date Set: 1990

Set By (Agency): DCSO

Date Recovered: 1/8/91


Recovered By: SJF - TF

Date Recovered: _____

Recovered By: _____

Date Recovered: _____

Recovered By: _____

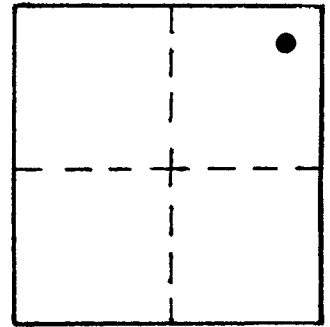

DESCRIPTION and TO REACH

43 03 15

SKETCH

123 12 31

PRIVATE DR #5622

NORTH MYRTLE RD
(Co. Rd. #15)

PRIVATE DR #5589

WITNESS POST
+ SIGN
EAST
2'

Reference Marks:

NEARLY
OK

Note: For further information, contact the Douglas County Surveyor's Office, Room 205 Douglas County Justice Building, Roseburg, OR 97470. Phone 440-4278. Douglas County residents outside the Roseburg calling area, dial toll free 1-800-452-0991.