

Date Set: 1987

Set By (Agency): NGS

DCSO Designation: F-040

Date Recovered: 7-22-93



Recovered By: RWS SJF

Date Recovered: \_\_\_\_\_

Recovered By: \_\_\_\_\_

Date Recovered: \_\_\_\_\_

Recovered By: \_\_\_\_\_

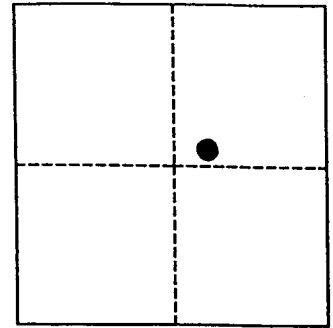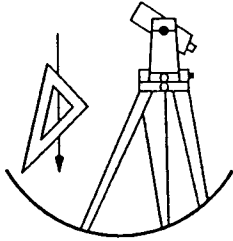

VERTICAL CONTROL

~~NAVD 88~~ ~~NAVD 29~~ Elevation: 334.600 FEET      NAVD 88 Elevation: 101.986 METERS

NGS Line # L25035    USGS LINE # \_\_\_\_\_    OSHD Line # \_\_\_\_\_    FILE # \_\_\_\_\_

Precision: 1ST ORDER    Agency: NGS    Proj: \_\_\_\_\_    Date: 1988

HORIZONTAL CONTROL

O.C.S. 27    Y(Northing): \_\_\_\_\_    O.C.S. 83    Y(Northing): 753134

(South Zone)    X(Easting): \_\_\_\_\_    (South Zone)    X(Easting): 4187444

Precision: GIS SCALED    Agency: DCSO    Proj: \_\_\_\_\_    Date: 2014

Approx. O.C.S. 27 Geographic Position:    Latitude: 43°41'45"    Longitude: 123°16'09"

Approx. O.C.S. 83 Geographic Position:    Latitude: \_\_\_\_\_    Longitude: \_\_\_\_\_

Found: A 3 - 5/8 inch diameter NGS disk stamped "F 739 1987" set flush in rock out-crop approx. 2 - 1/2 feet above road surface.

To reach: At the intersection of State Hwy 38 and Rock Creek Rd. (Co. Rd. #178A) in T21S R5W Sec. 34 monument is at northwest corner of intersection.

