
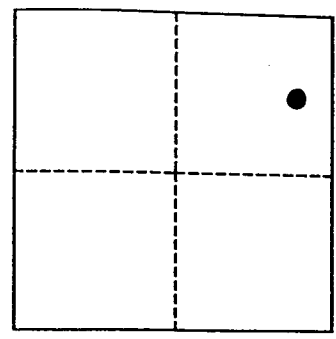


OFFICE OF THE
DOUGLAS COUNTY SURVEYOR

Station: F 747
 Date Set: 1987
 Set By (Agency): NGS
 DCSO Designation: F-041
 Date Recovered: 8-93
 Recovered By: RWS SJF
 Date Recovered: _____
 Recovered By: _____
 Date Recovered: _____
 Recovered By: _____

T29S R6W Sec. 02

F-041

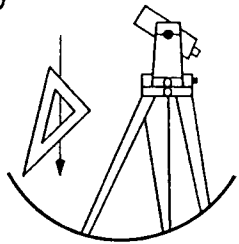

VERTICAL CONTROL

~~NAVD 88~~ Elevation: 548.458 FEET NAVD 88 Elevation: 167.170 METERS
 NGS Line # 125042 USGS LINE # _____ OSHD Line # _____ FILE # _____
 Precision: 1ST ORDER Agency: NGS Proj: _____ Date: 1988

HORIZONTAL CONTROL

O.C.S. 27 Y(Northing): _____ O.C.S. 83 Y(Northing): 528114
 (South Zone) X(Easting): _____ (South Zone) X(Easting): 4155404
 Precision: GIS SCALED Agency: DCSO Proj: _____ Date: 2014
 Approx. O.C.S. 27 Geographic Position: Latitude: 43°04'48" Longitude: 123°21'56"
 Approx. O.C.S. 83 Geographic Position: Latitude: _____ Longitude: _____

Found: A 3 - 5/8 inch diameter NGS disk stamped "F 747 1987" set in a large rock out-cropping.

To reach: Go to the intersection of Dillard Hwy (Co. Rd. #387) and Dole Rd. (Co. Rd. #14) in T29S R6W Sec2, proceed easterly along Dole Rd. approx. 0.2 mile to east end of bridge over South Umpqua River. Monument is near southeast end of bridge in exposed river bedrock.

