



OFFICE OF THE
DOUGLAS COUNTY SURVEYOR

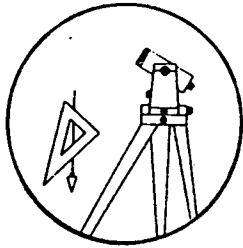

G-004

Station: G 500 T 30 S, R 3W, Sec 34
 Set By (Agency): USC&GS
 Date Set: 1949
 Recovered By JP-RS
 Date Recovered 3-17-82
 Recovered By 5-29-98
 Date Recovered _____
 Recovered By _____
 Date Recovered _____

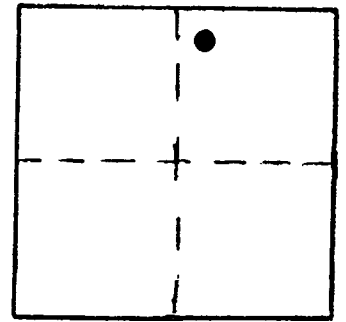

VERTICAL CONTROL CORPSCON6 NAVD88 915.699 FT.

Elevation: 912.291 NGS Line # 130 USGS Line # _____ OSHD Line # _____
 Precision: 2nd Agency: USC&GS Proj. # _____ Date: 1957

HORIZONTAL CONTROL


South Zone State Plane Coordinates: Y(Northing) 471030 X(Easting) 4238509
 Precision: GIS SCALED Agency: DCSO Proj. # _____ Date: 2014
 Approximate Geographic Position: Latitude 42° 55' 50" Longitude 123° 02' 55"

DESCRIPTION and TO REACH

SKETCH

Found: A standard USC&GS disk set in 12" concrete post marked "G 500 1949". Witness sign and post are directly along Westerly side. Station is .3ft above ground and about level with the road surface.

To reach: From the junction of St. Hwy. #227 and BLM Rd. 30-3-26.0 (Corn Creek) T30S R3W sec. 26 proceed Westerly along St. Hwy. #227 1.45 miles to station on the left or the southerly side of road.

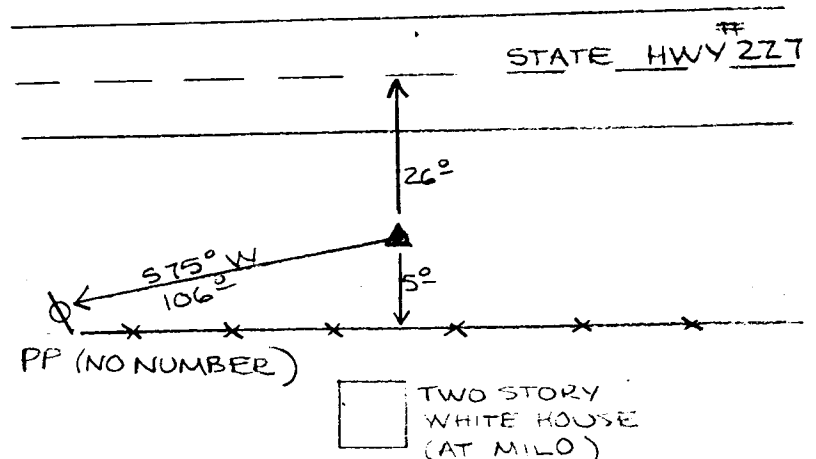

Reference Marks:

Note: For further information, contact the Douglas County Surveyor's Office, Room 205 Douglas County Justice Building, Roseburg, OR 97470. Phone 440-4278. Douglas County residents outside the Roseburg calling area, dial toll free 1-800-452-0991.