


OFFICE OF THE

g-006
G-666

24S 5W 29

DOUGLAS COUNTY SURVEYOR

NAD 666553.73 4172206.59
83 43°27'40" 123°19'19"

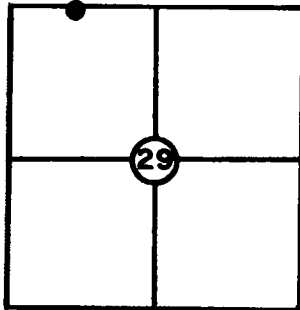

T 24 S, R 5W, Sec. 29

Station: G-666

Set By (Agency): OSHD

Date: 1975 (FD OK 1991)

VERTICAL CONTROL CORPSCON 6 NAVD 88 490.33 FT

NAVD 29 486.80
Elevation: ~~486.796~~

OSHD
NGS(USC&GS) Line # _____ U66S Line # 369

Order
Of Precision 3rd Agency: OSHD Proj. #: _____ Date: 1956

HORIZONTAL CONTROL


OCS 27
Oregon State Plane Coordinates: Y(Northing) 666,588.12 X(Easting) 1,251,247.06
(South Zone)

Order
Of Precision 1/25,000 Agency: DCSO Proj. #: 2010-4 Date: 1978

Approximate Geographic Position: Latitude= 43° 27' 40" Longitude= 123° 19' 15"

DESCRIPTION: A standard OSHD brass cap
stamped "G-666 1975" set on top of the curb
at the NW'stly corner of the Metz Hill
overpass across I-5.

SKETCH

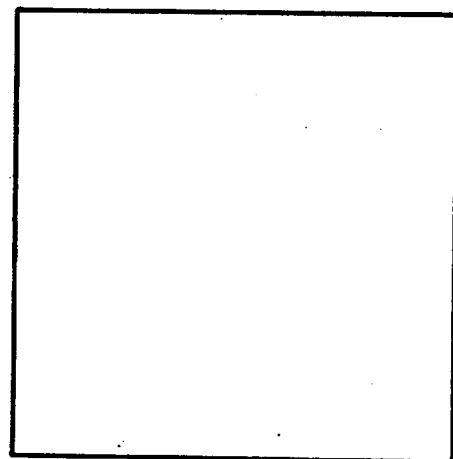

VICINITY: At Metz Hill interchange along
I-5.

NOTE: For Possible Further Information On This Station, Please Contact The Douglas County Surveyors Office, Rm. 205 Douglas County Justice Bldg., Roseburg, OR. 97470 Phone 672-3311 Ext. 272.. Douglas County residents outside the Roseburg calling area dial toll free 1-800-452-0991.