

1/4/82


g-024
GINGER

26S 6W 14

OFFICE OF THE

DOUGLAS COUNTY SURVEYOR

NAD 609424.35 4155977.54
83 43°18'10" 123°22'32"

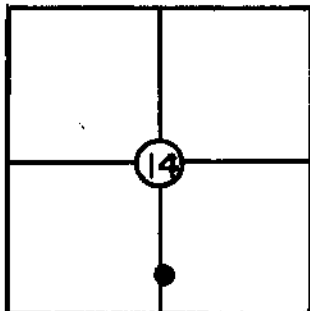

T 26 S, R 6 W, Sec. 14

Station: GINGER

Set By (Agency): DCSO

Date: 1981

VERTICAL CONTROL

Elevation: _____ NGS(USC&GS) Line # _____ USGS Line # _____

Order
Of Precision _____ Agency: _____ Proj. #: _____ Date: _____

HORIZONTAL CONTROL

OCS 27
Oregon State Plane Coordinates: Y(Northing) 609,459.37 X(Easting) 1,235,018.68
(South Zone)


Order
Of Precision 1/25,000 Agency: DCSO Proj. #: 2013 Date: 1981

Approximate Geographic Position: Latitude= 43° 18' 11" Longitude= 123° 22' 28"

DESCRIPTION: Monument is a brass cap set
in NE cor. of bridge curb stamped "Ginger 1981".

To reach: From the intersection of Co. Rd.
31 (Wilbur Rd.) and Co. Rd. # 115
proceed E'stly along Co. Rd. # 115 approx.
320 ft. to first bridge over Sutherlin Creek.

SKETCH

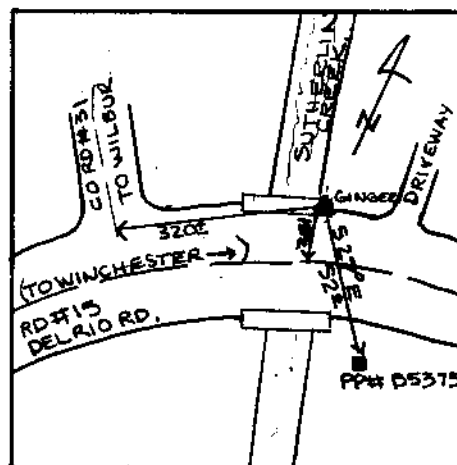

VICINITY: Near the intersection of

Co. Rd. #31 and Co. Rd. #115.

over Sutherlin Creek.
NOTE: For Possible Further Information On This Station, Please Contact The Douglas
County Surveyors Office, Rm. 205 Douglas County Justice Bldg., Roseburg, OR.
97470 Phone 672-3311 Ext. 272. Douglas County residents outside the
Roseburg calling area dial toll free 1-800-452-0991.