

OFFICE OF THE
DOUGLAS COUNTY SURVEYOR

Station: GLIDE T 26 S, R 3 W, Sec 19

Set By (Agency): OSHD

Date Set: 1937

Recovered By LEM


Date Recovered 5-80

Recovered By _____

Date Recovered _____

Recovered By _____

Date Recovered _____

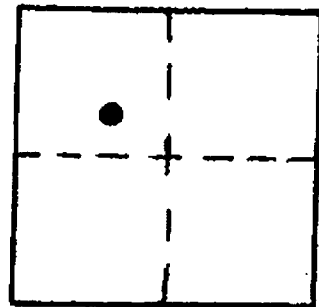

g-030
GLIDE

265 3W 19

NAD 604962.16 4228595.43
83 43°17'50" 123° 6' 9"

VERTICAL CONTROL NGVD 29 (CORPSCONG NAVD 88) 711.47 FEET

Elevation: 707.912 NGS Line # 94 USGS Line # _____ OSHD Line # _____

Precision: 1st Agency: USC&GS Proj. # _____ Date: 1961

HORIZONTAL CONTROL DCS 27

South Zone State Plane Coordinates: Y(Northing) 604,997.69 X(Easting) 1,307,635.43

Precision: 1/25,000 Agency: DCSO Proj. # 2006 Date: 1973

Approximate Geographic Position: Latitude 43°17'50" Longitude 123°06'04"


DESCRIPTION and TO REACH

SKETCH

Found: A standard OSHD disk stamped "Glide 1937".
Disk is set in massive rock outcropping above river
(South of river-North of Hwy. 138) at intersection
of Hwy 138 & Little River Rd. (Co. Rd. #17A). Disk
is approximately level with Rd. surface

To reach: At the intersection of Hwy. 138 & Little
River. South of river and North of Hwy. 138.

NOTE: Brass cap set on bluff immediately above river &
50' northerly of north edge of pavement, St. Hwy. 38.

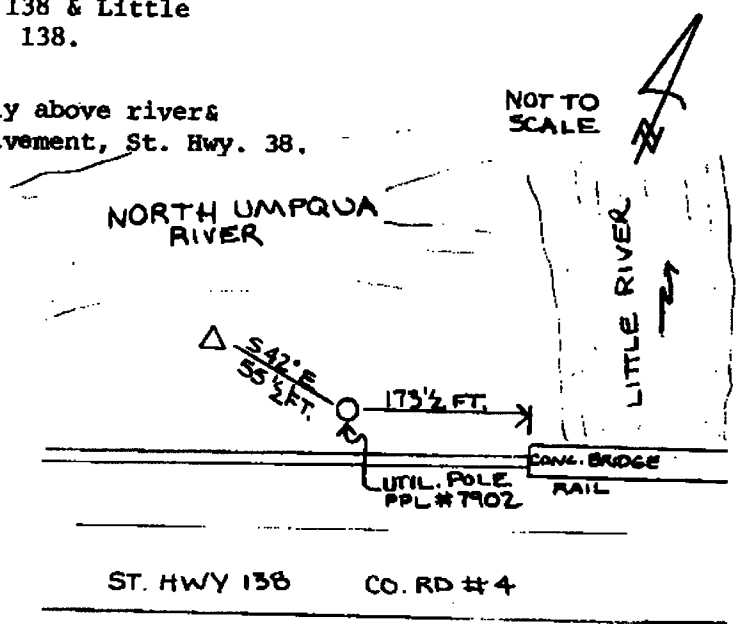

Reference Marks:

ST. HWY 138 CO. RD # 4

Note: For further information, contact the Douglas County Surveyor's Office, Room 205
Douglas County Justice Building, Roseburg, OR 97470. Phone 440-4278. Douglas
County residents outside the Roseburg calling area, dial toll free 1-800-452-0991.